


33654

T.3S., R.25E., W.M.

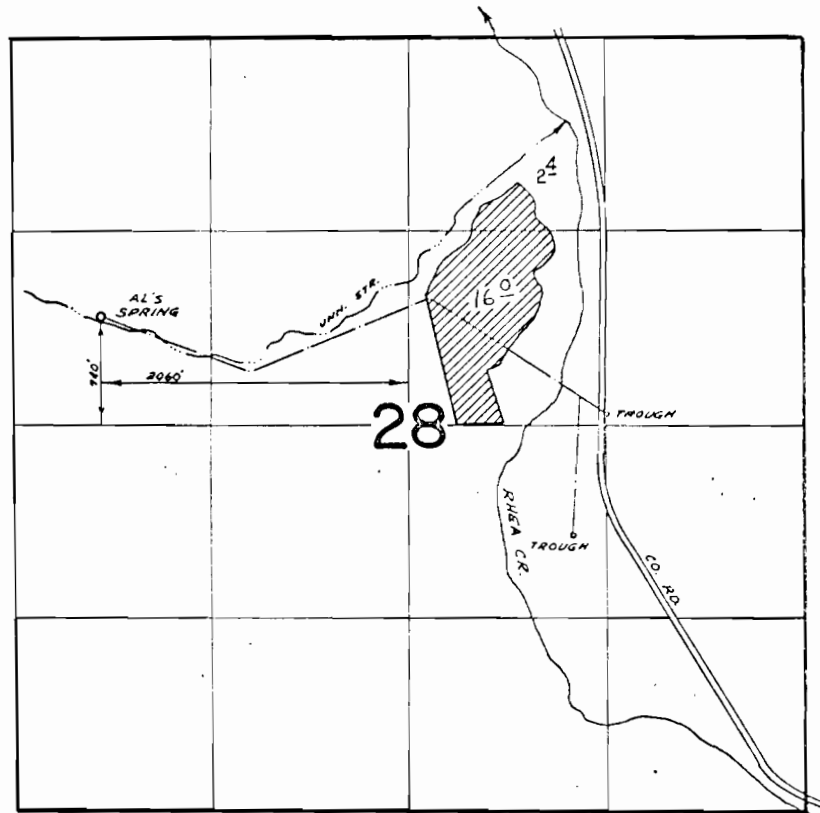

FINAL PROOF SURVEY UNDER

Application No. 45027 Permit No. 33654
IN NAME OF

ALFRED L. LOVGREN

Surveyed May 9 1974, by R. Norby