


T. 27 S., R. 34 E., W.M.

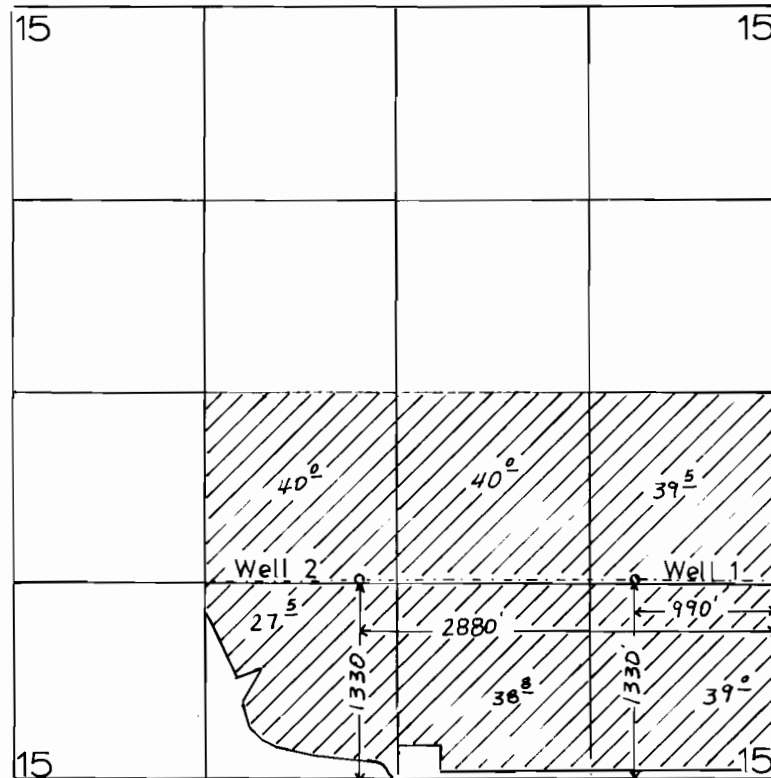

1"=1320'

FINAL PROOF SURVEY

UNDER

Application No. G-9470 Permit No. G-8872
IN NAME OF

CONLEY MARSHALL

Surveyed NOVEMBER 25, 1996, by J. MILLER