


T. 37 S., R. 36 E., W.M.

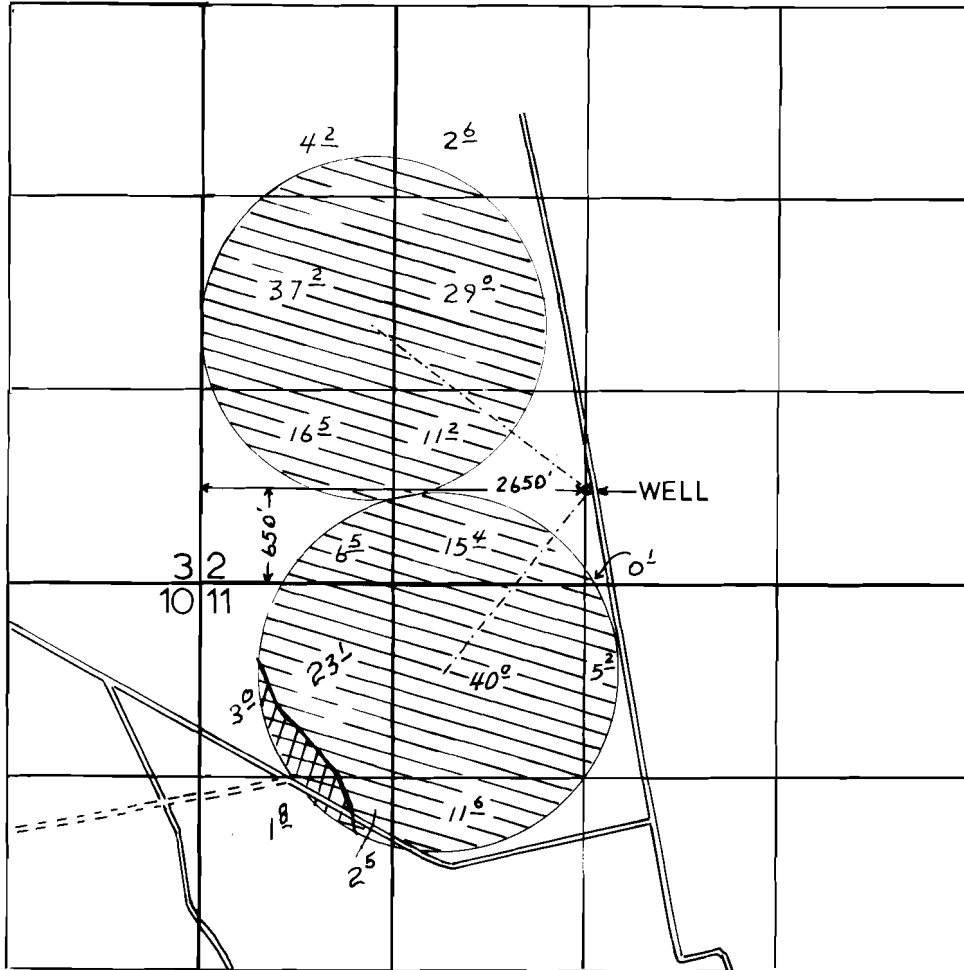

FINAL PROOF SURVEY UNDER

Application No. G-10392 Permit No. G-9459
IN NAME OF

WHITEHORSE RANCH

Surveyed SEPTEMBER 15, 1994, by J. MILLER