


Township 14 & 15 South, Range 31 East, W.M.

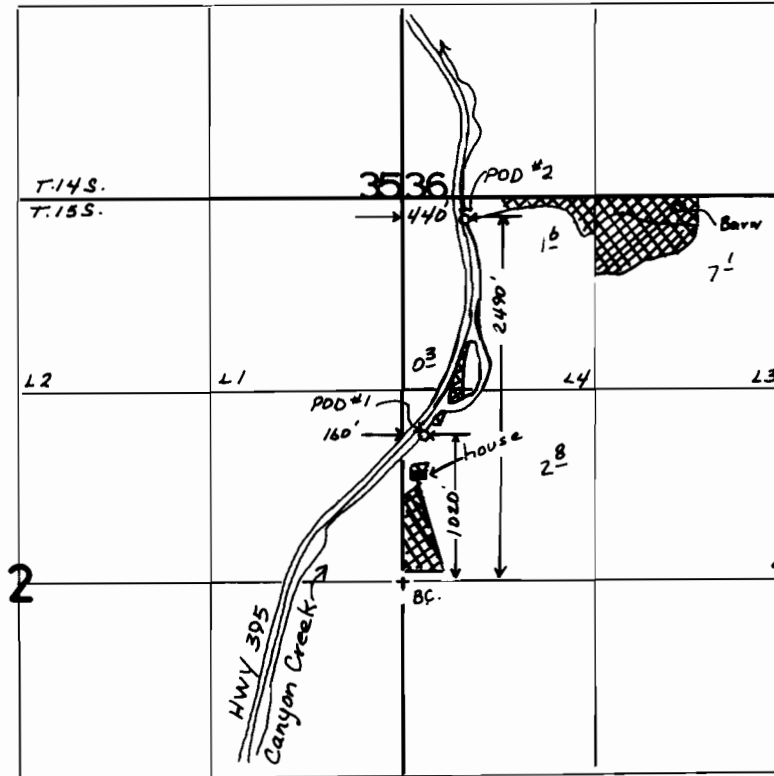

1" = 1320'

FINAL PROOF SURVEY UNDER

Application No. 67321.. Permit No. 48150.....
IN NAME OF

.....ROBERT & VERA MARTIN.....

Surveyed Aug. 12 1999, by J. Miller.....
Sept. 13 2000