


T.13S. R.33E. W. M.

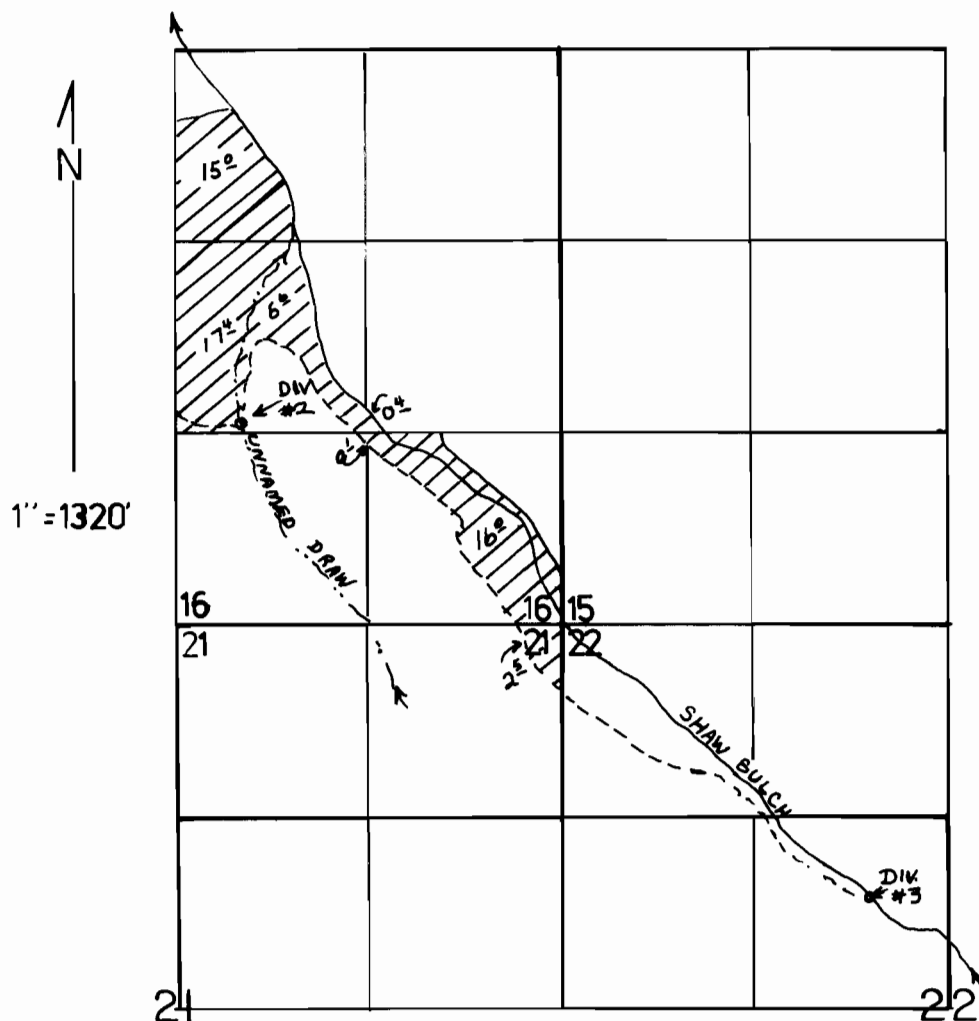

Diversion #2 1400' N & 450' E from S $\frac{1}{4}$ corner Section 16

Diversion #3 1800' S & 4750' E from S $\frac{1}{4}$ corner Section 16

FINAL PROOF SURVEY UNDER

Application No. 68289 Permit No. 49426..
IN NAME OF

T.N. & NEDINE F. BARNHOUSE.....

Surveyed 11-22... 1991.. by J. MILLER.....

41023-279-92L
9M 1-28-92