


T. 11 S., R. 20 E., W.M.

-  PRIM. UN. DRAW POD #1
SUPP. W. BR. BRIDGE CR. POD # 3.
-  LAND IRR. FR. POD # 2
DITCH NORTH SIDE
-  LAND IRR. FR. POD # 2
DITCH SOUTH SIDE
-  LAND IRR. FR. POD # 3
-  LAND IRR. FR. POD # 2
DITCH SOUTH SIDE, &/or POD # 3.
-  LAND IRR. FR. POD # 4.

1" = 1320'

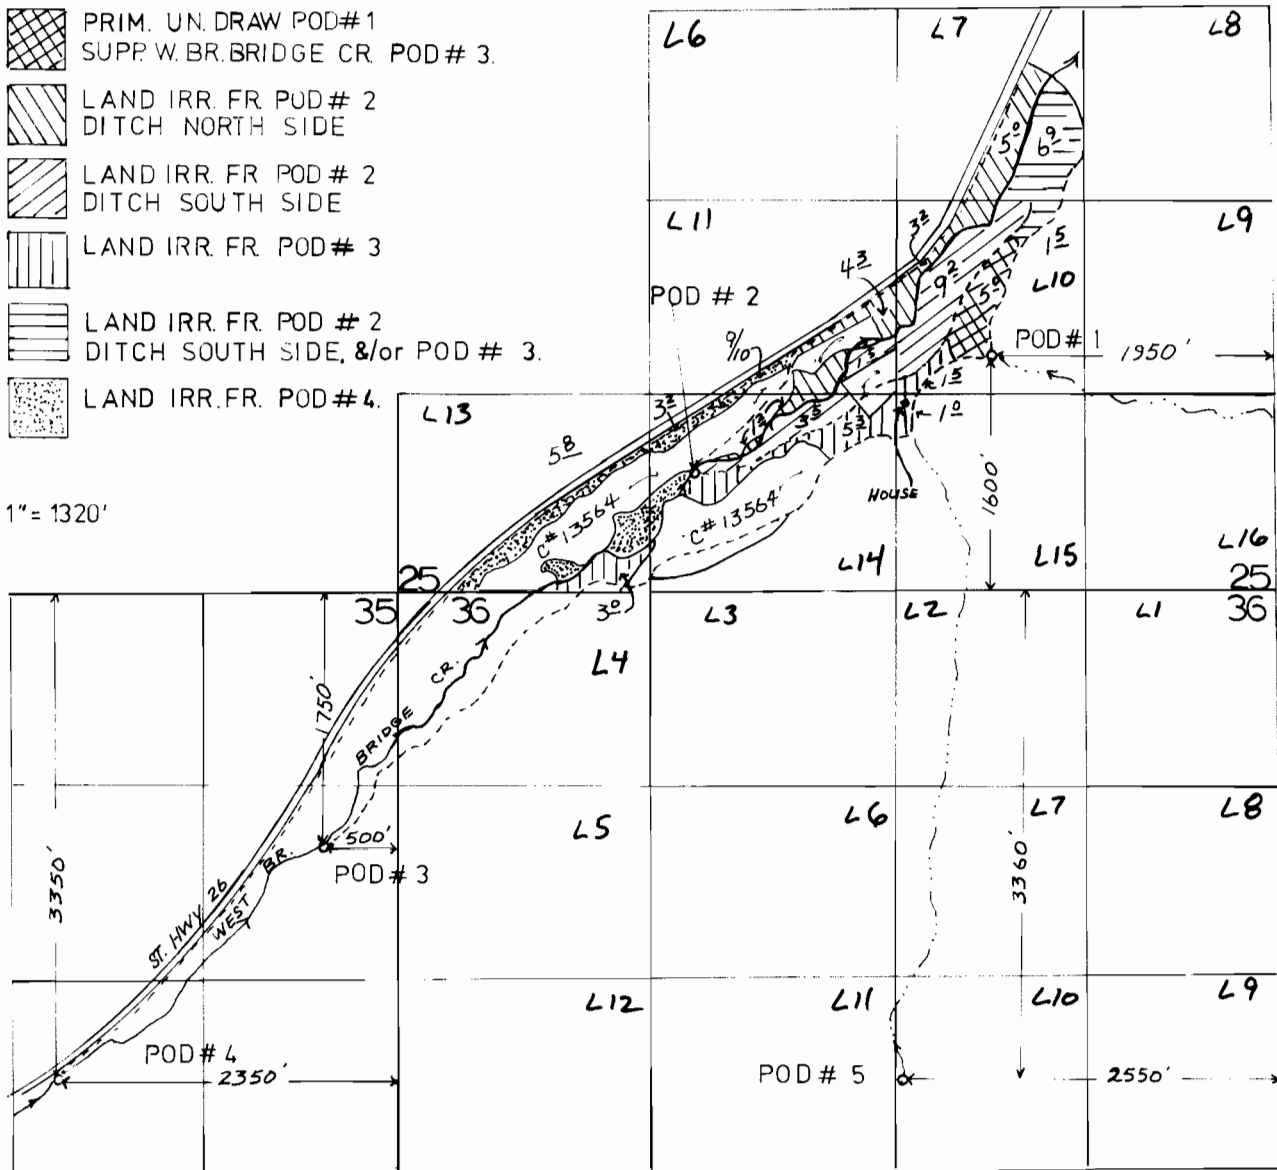

POD # 2 - 800' NORTH AND 2030' EAST FROM SOUTHWEST CORNER SECTION 25.

FINAL PROOF SURVEY UNDER

Application No. 64480 Permit No. 47328
IN NAME OF

JAMES AND JOYCE BROOKS

Surveyed 3-5, 1992, by J. MILLER

