


T.7S., R.2W., W.M.

RECEIVED

OCT 28 1997

WATER RESOURCES DEPT
SALEM, OREGON

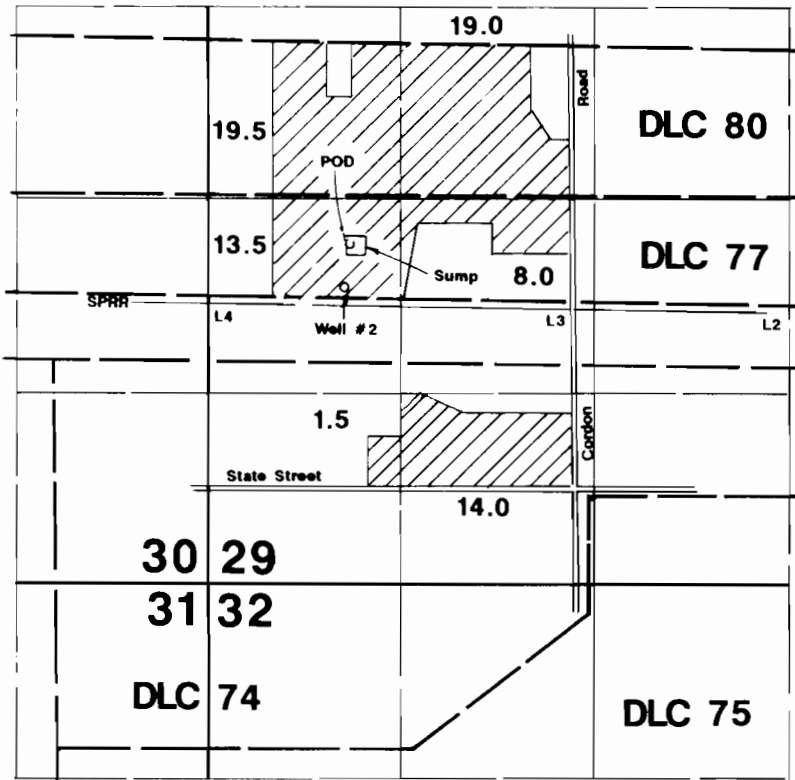

Well #2 located 1450'N & 1620'W
POD located 1720'N & 1600'W--both from most northerly corner DLC 75.

Final Proof Survey

Application #: G-13001 Permit #: G-11940

In Name Of

Myron Kuenzi

Surveyed on October 14, 1997 by JM Schuette

THIS MAP WAS PREPARED FOR THE PURPOSE OF IDENTIFYING THE LOCATION OF A WATER RIGHT ONLY AND IS NOT INTENDED TO PROVIDE LEGAL DIMENSIONS OR LOCATION OF PROPERTY OWNERSHIP LINES.

