


TOWNSHIP 22 SOUTH, RANGE 30 EAST, W.M.

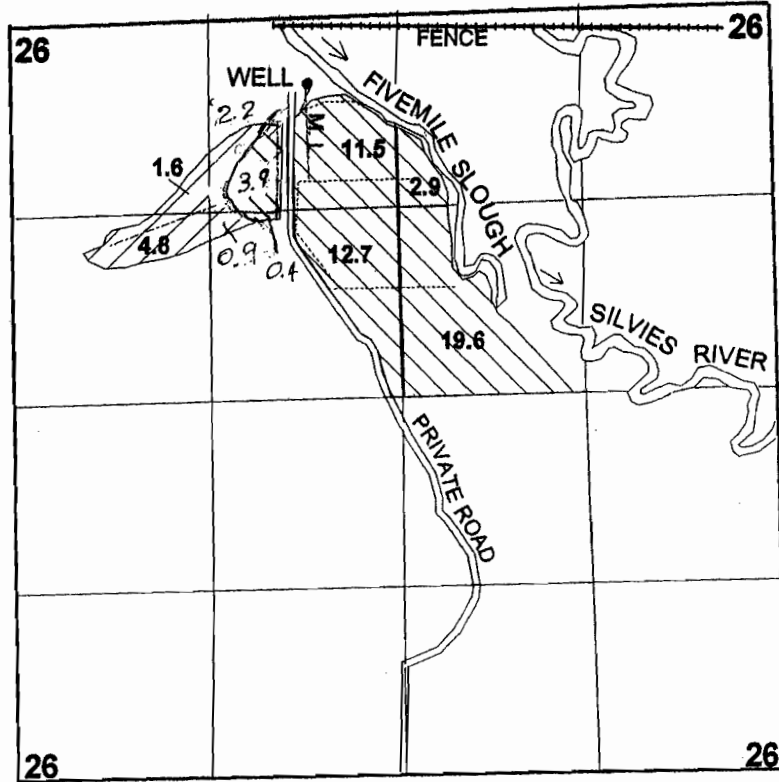

WELL ONE - 9860' NORTH AND 3125' WEST FROM
THE SOUTHEAST CORNER OF SECTION 35.

**FINAL PROOF SURVEY
UNDER**

Application No. G-10578 Permit No. G-10048
IN THE NAME OF

Surveyed: August 6, 2001 by: J. Miller

RECEIVED

MAR 03 2003

WATER RESOURCES DEPT.
SALEM, OREGON

AMENDED 04/27/06 LHN
41025-279-169L & Leica GPS JM 2-26-2003