


T.25S., R.31E., W.M.

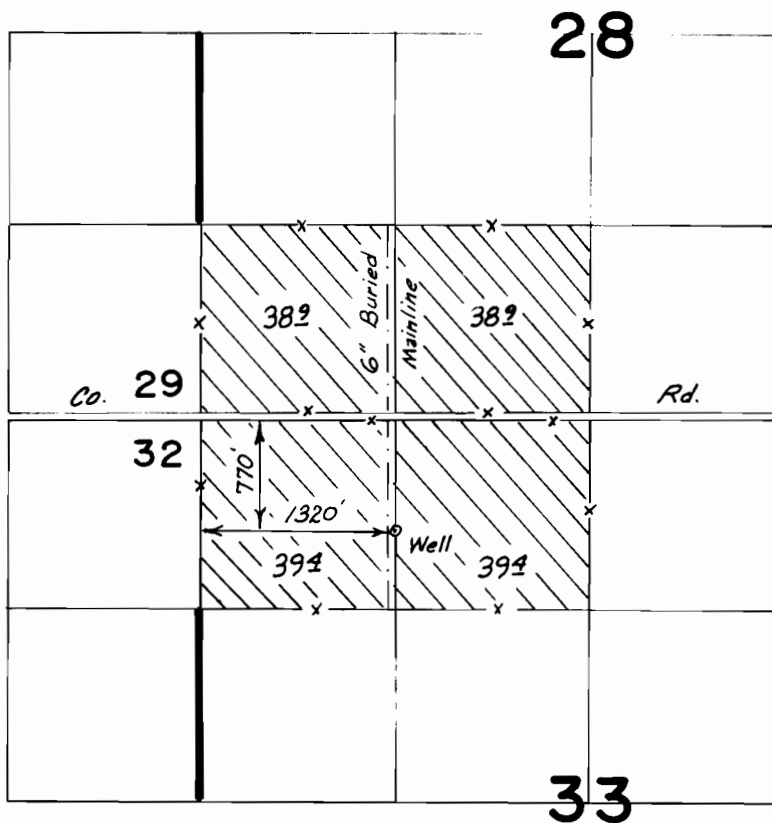

FINAL PROOF SURVEY UNDER

Application No. G11106.. Permit No. G10397..
IN NAME OF

.....ROBERT N. CARGILL.....

Surveyed 5-7..... 1988., by Tom Warren.....



Scale: 1" = 1320'