



T. 25S., R. 31E., W. M.

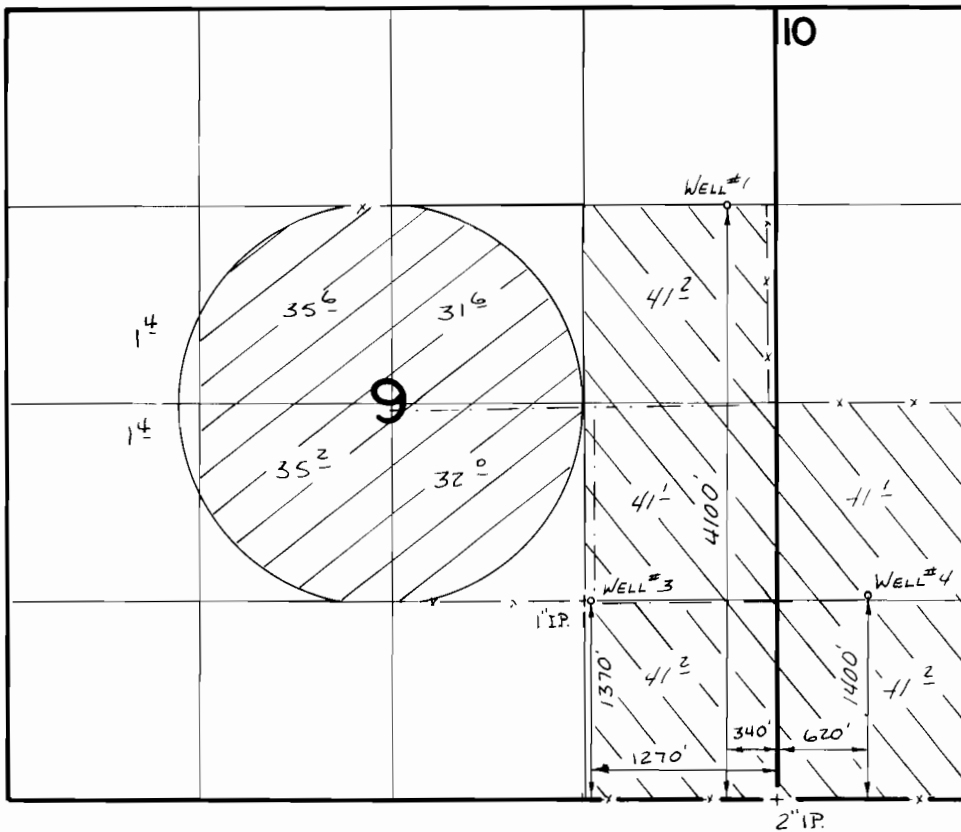

SCALE 1" = 1320'

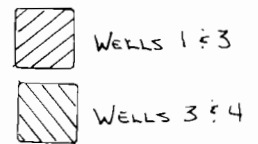

**FINAL PROOF SURVEY**  
UNDER

Application No. **G:10688** Permit No. **G:9879**  
IN NAME OF

**J.W. McCALLISTER & JETT C. BLACKBURN**

Surveyed 5-9..... 1988, by T.M. WARREN.....