


Township 7 S., Range 29 E., W.M.

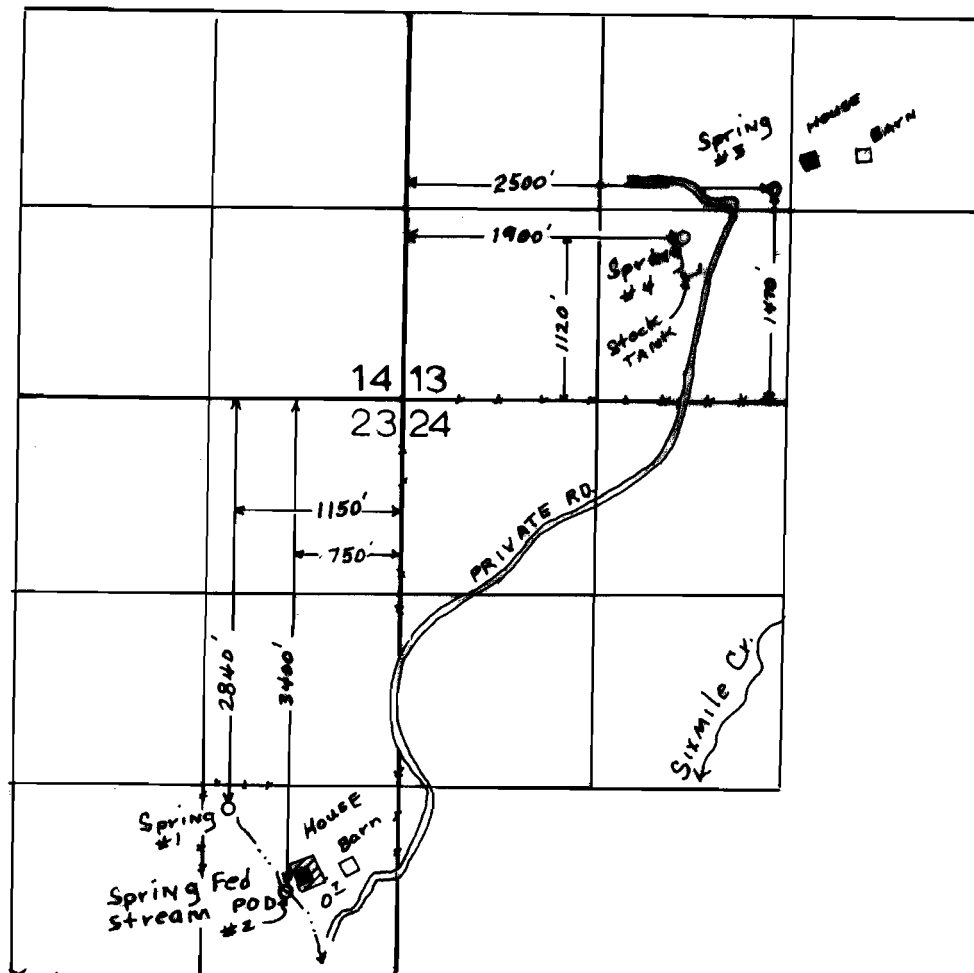

1"= 1320'

FINAL PROOF SURVEY UNDER

Application No. 58873 Permit No. 44966

IN NAME OF

WARREN CONSTANT

Surveyed SEPT. 16 1999, by J. Miller