


T. 8 S., R. 28 E., W. M.

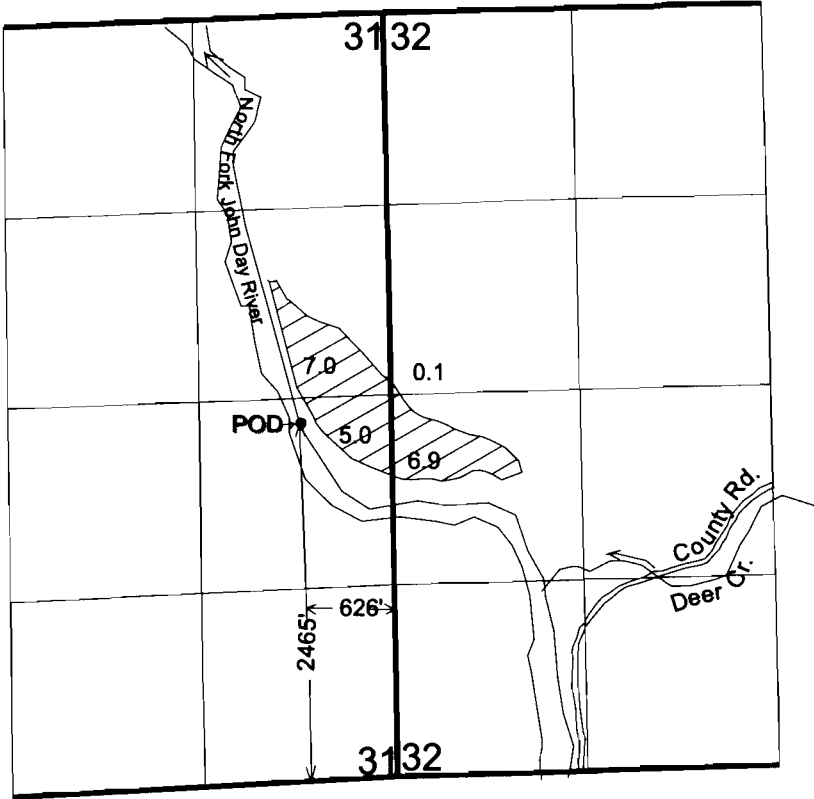

1" = 1320'

FINAL PROOF SURVEY
UNDER

Application No. 65244 Permit No. 47667
IN THE NAME OF

Surveyed 10-23-2001, By J. Miller