


T. 25 S., R. 31 E., W.M.

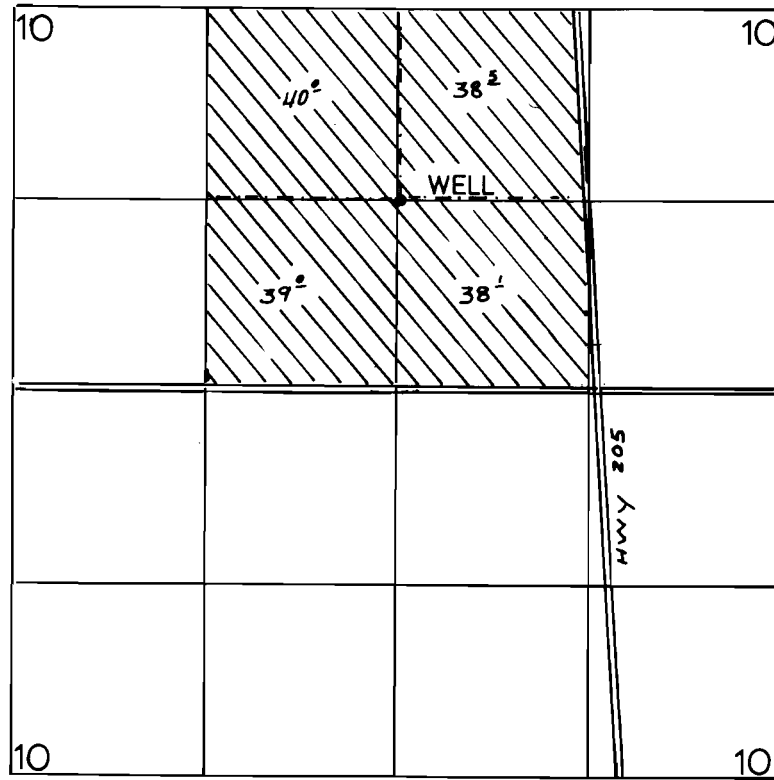

N
1" = 1320'

WELL - 1315' S. & 2635' W. from the N.E. Corner Sec. 10.

FINAL PROOF SURVEY
UNDER

Application No. G-9408 Permit No. G-8705
IN NAME OF

CHESTER LEE HIBBITTS AND FRIEDA KAY FLOCK

Surveyed AUGUST 10, 1983, by J. MILLER