


T 22S, R 32E, WM

RECEIVED

AUG 02 1999

WATER RESOURCES DEPT
SALEM, OREGON

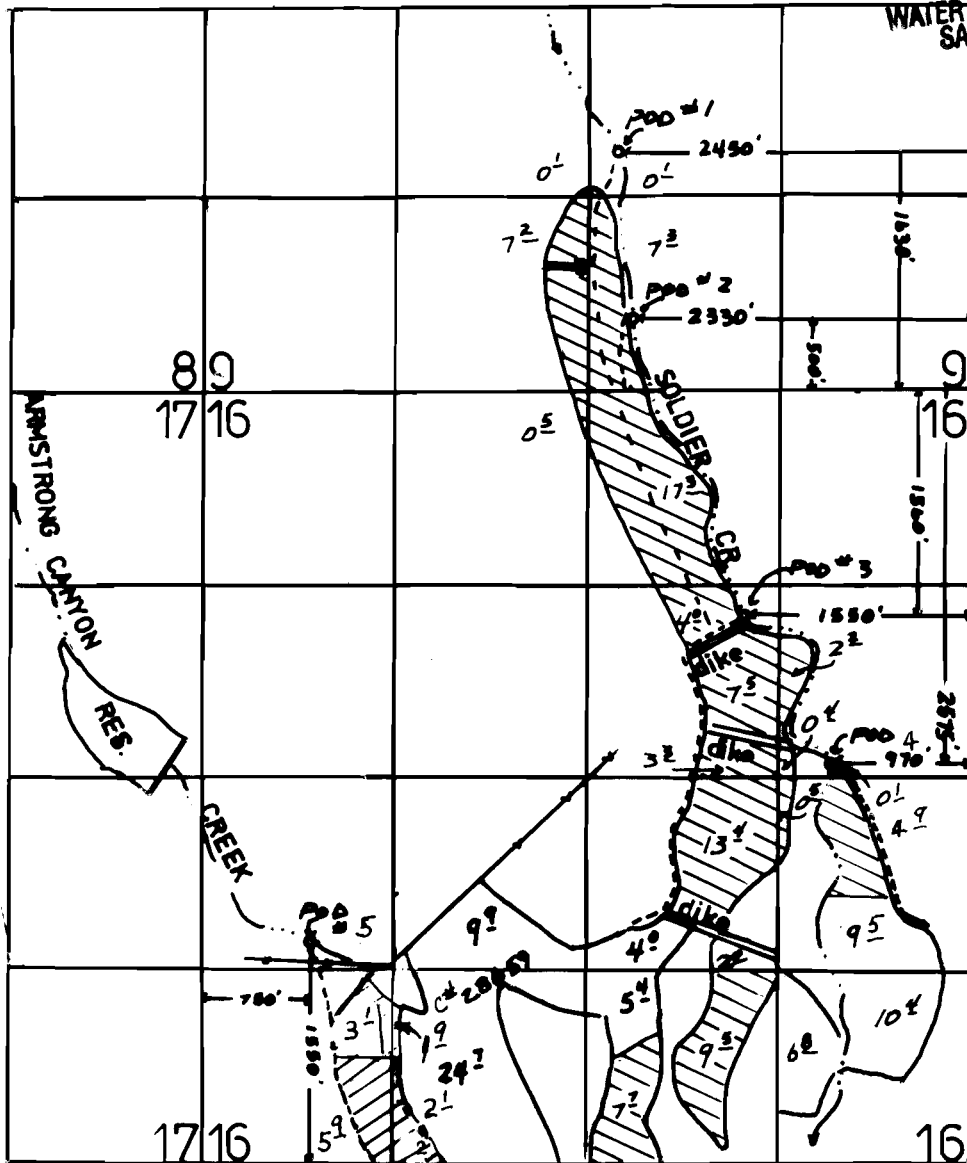

FINAL PROOF SURVEY
UNDER

Application No. 67972... Permit No. 48440.....
IN NAME OF

.....JULIAN R. ZIMMERMAN.....

Surveyed 10-8..... 1998.., by J.MILLER.....



1" = 1320'

4/025-279-174R

4/28/06 LHM
2-26-99 JM