


Township 9 S., Range 27 E., W.M.

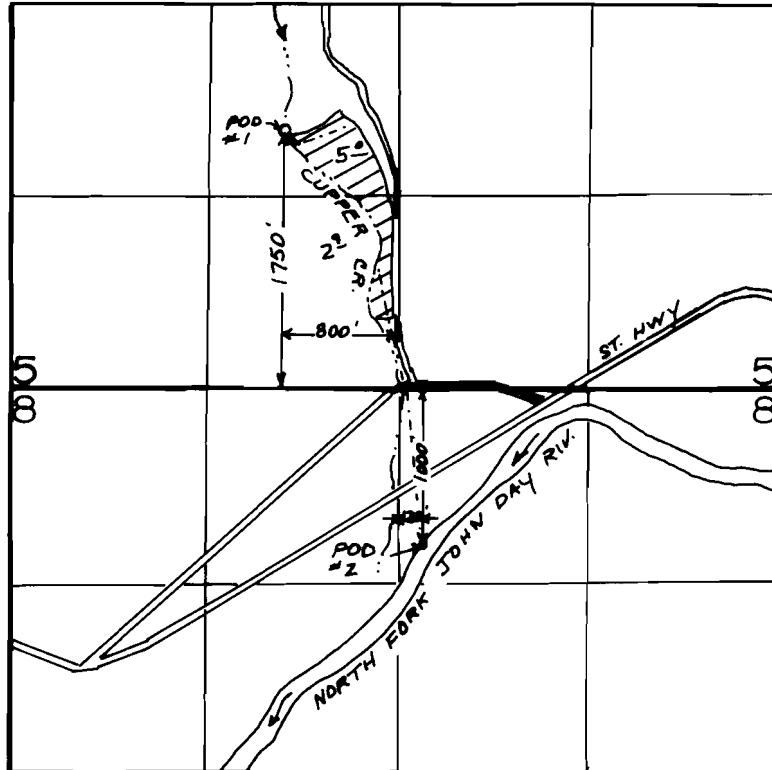

1" = 1320'

FINAL PROOF SURVEY
UNDER

Application No. 68317 Permit No. 49482
IN NAME OF

.....
Surveyed SEPT. 2, 99 by J. Miller
..... 19....., by