


T. 23 S., R. 32 E., W.M.

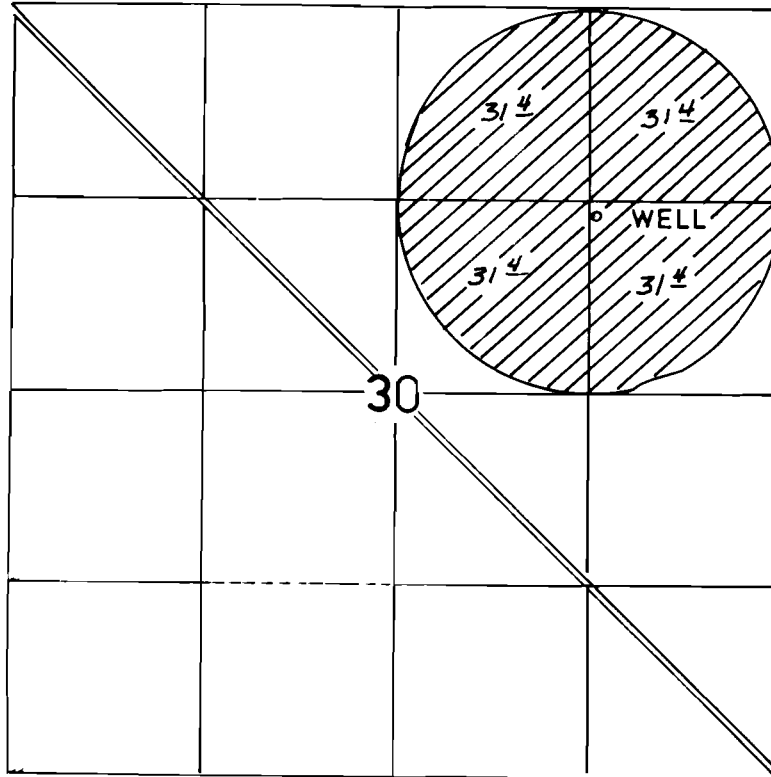

WELL 120' S. & 40' E. FROM THE CENTER OF
THE NORTHEAST CORNER SEC. 30.

FINAL PROOF SURVEY
UNDER

Application No. G-7488 Permit No. G-6964
IN NAME OF

JOHN PIERRE, ERNA ETHEL AND LINDA K. WATTS

Surveyed MAY 13, 1997, by L. MILLER