


T. 35 S., R 29 E., W. M.

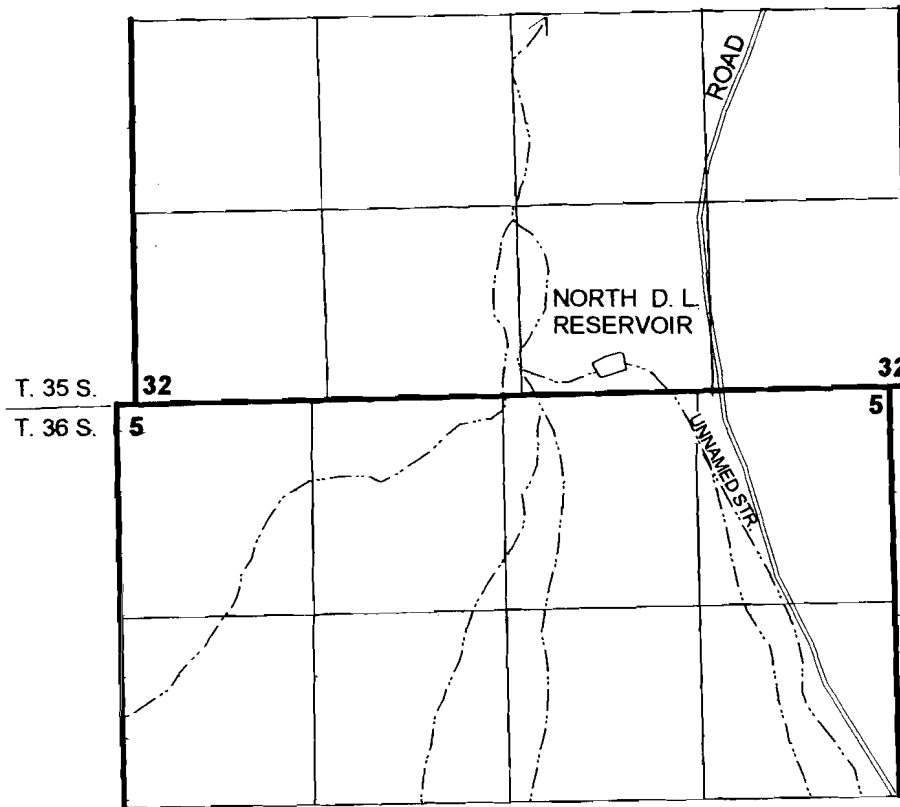

1" = 1320'

FINAL PROOF SURVEY

UNDER

Application No. R-65804 Permit No. R-11429

IN THE NAME OF

U. S. BUREAU OF LAND MANAGEMENT

Surveyed 9/20/2001 by J. Miller