


Old map

C-824
81462

Township 18 South, Range 17 East. W.M.

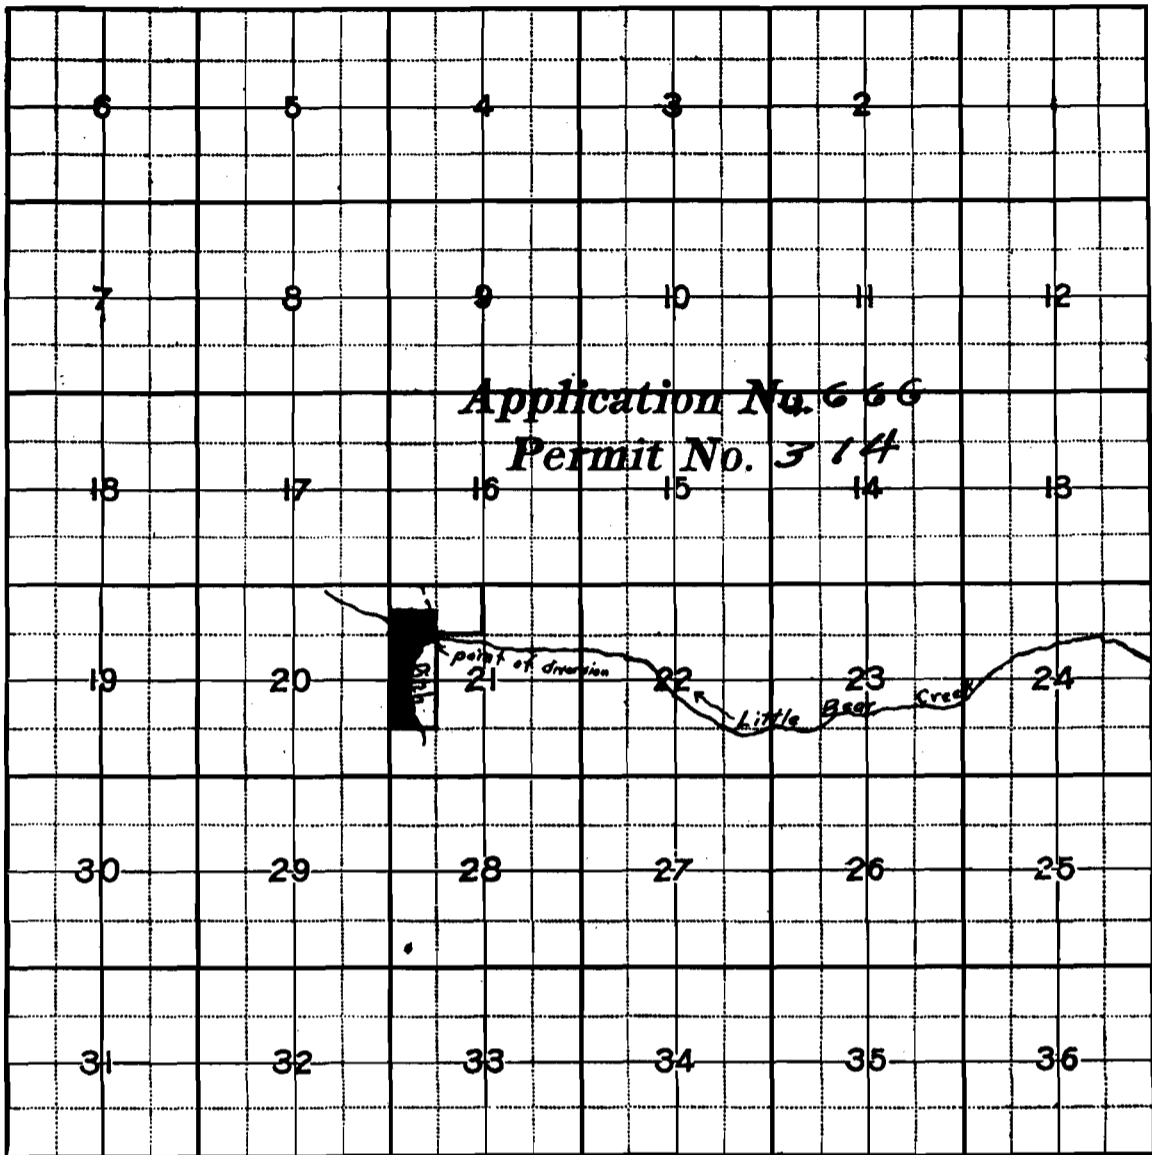

That marked in red is the ground that
I wish to irrigate.
W. H. W. Hamilton.