
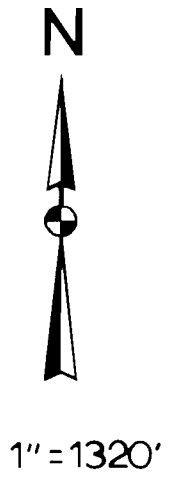


Township 13 South, Range 30 East, W.M.

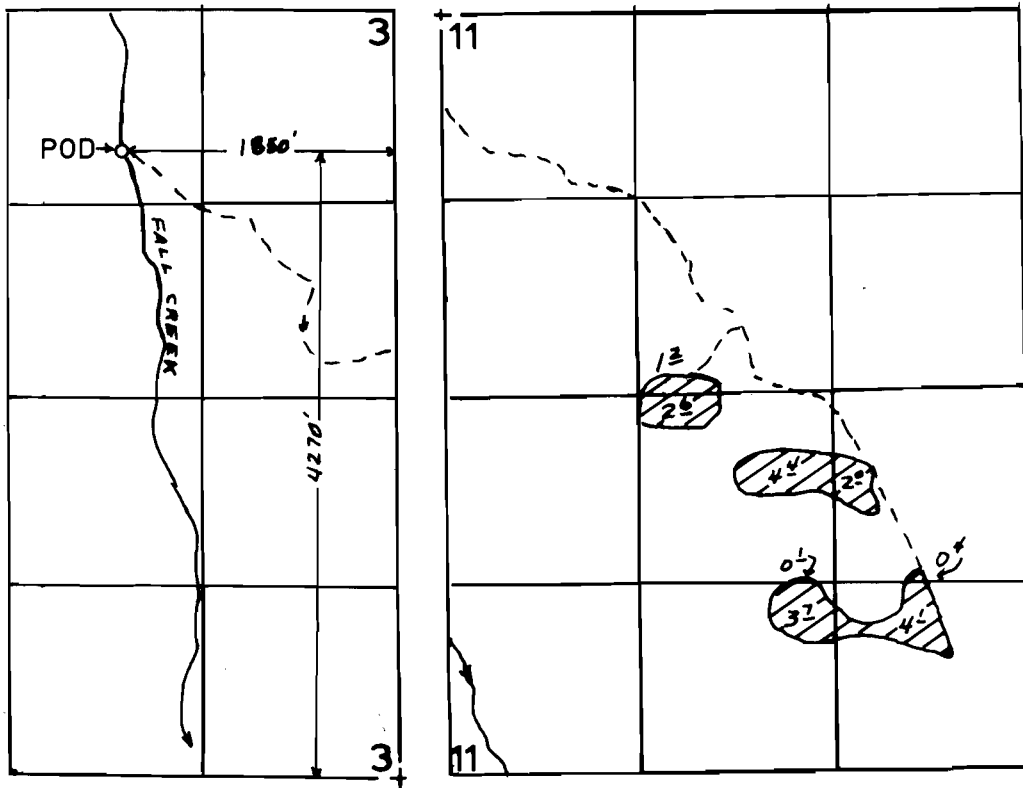

FINAL PROOF SURVEY UNDER

Application No. 67916.. Permit No. 48298.....
IN NAME OF

.....ROY KILPATRICK.....

Surveyed SEPT. 16, 1998., by J. Miller.....

RECEIVED