


T.9 S., R.26E., W.M.

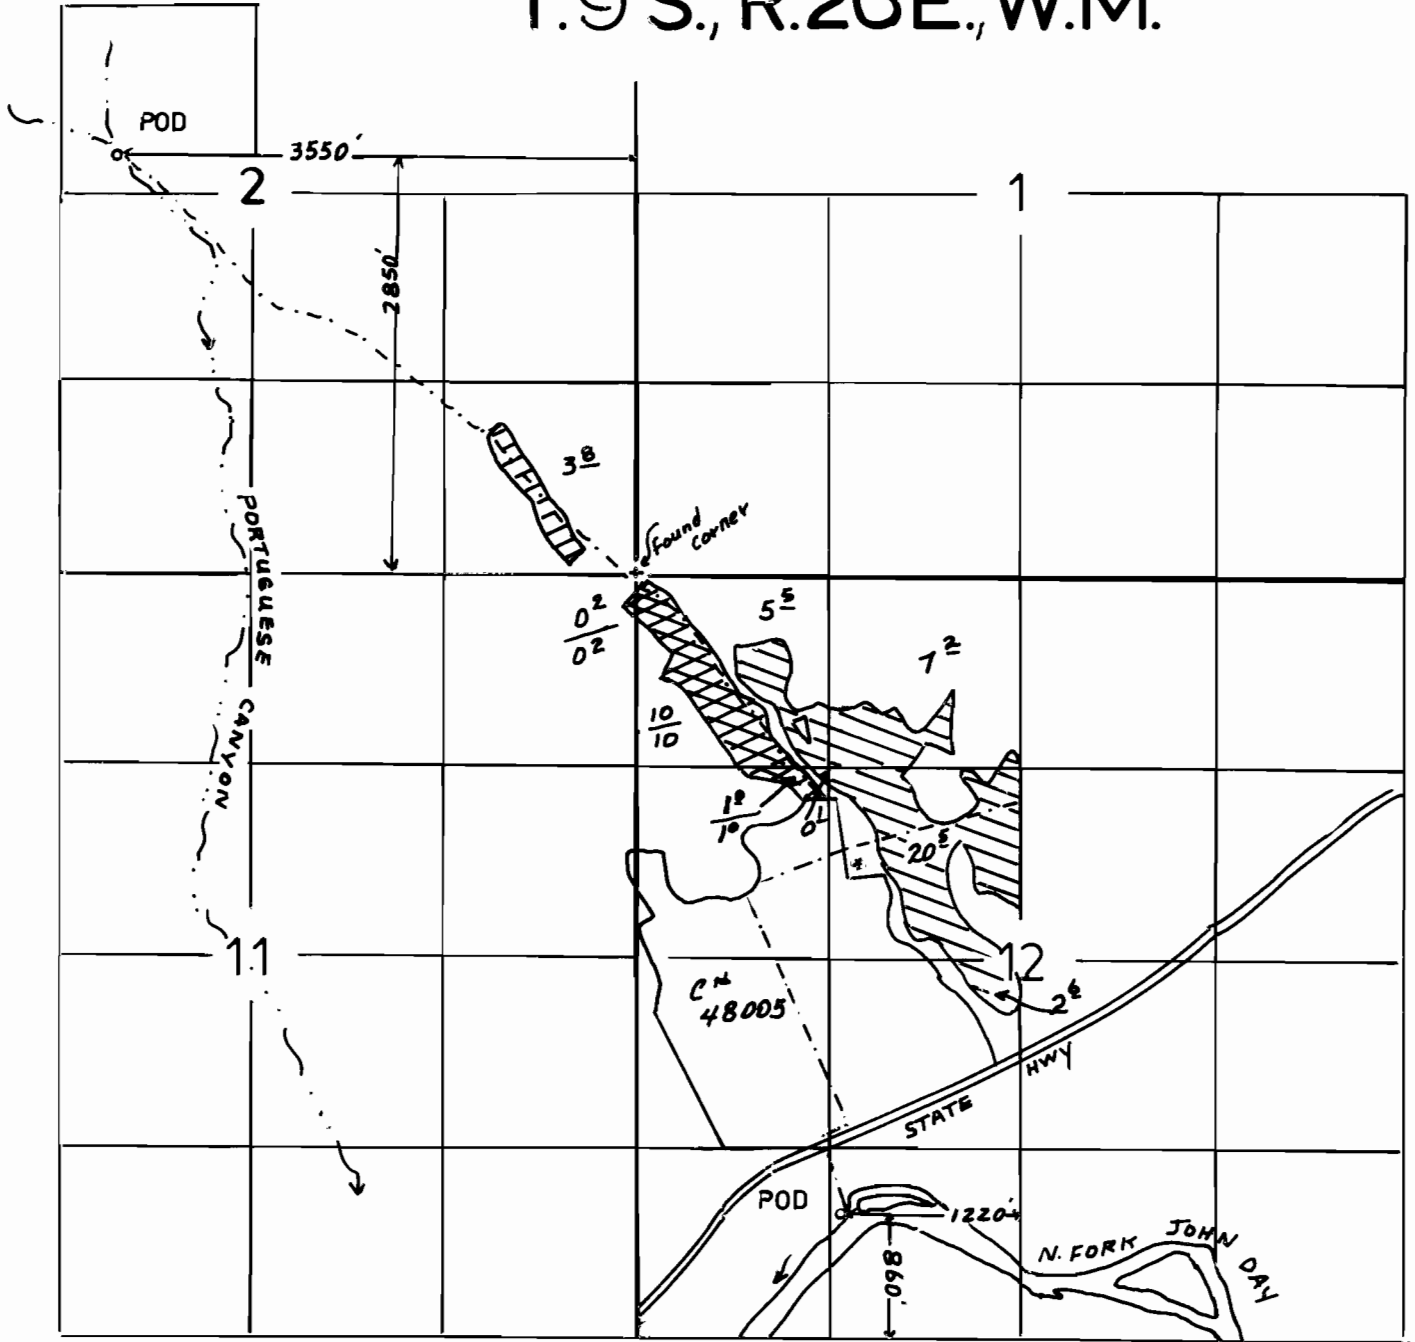

P 43147

P 44610

FINAL PROOF SURVEY UNDER

Application No. 57324 43147
 59323 Permit No. 44610.....
 IN NAME OF

.....DENNIS & LINDA ABRAHAM.....

Surveyed 9-20..... 1998., by J.MILLER.....



1"=1320'