


Township 11 South, Ranges 34 and 35 East, W.M.

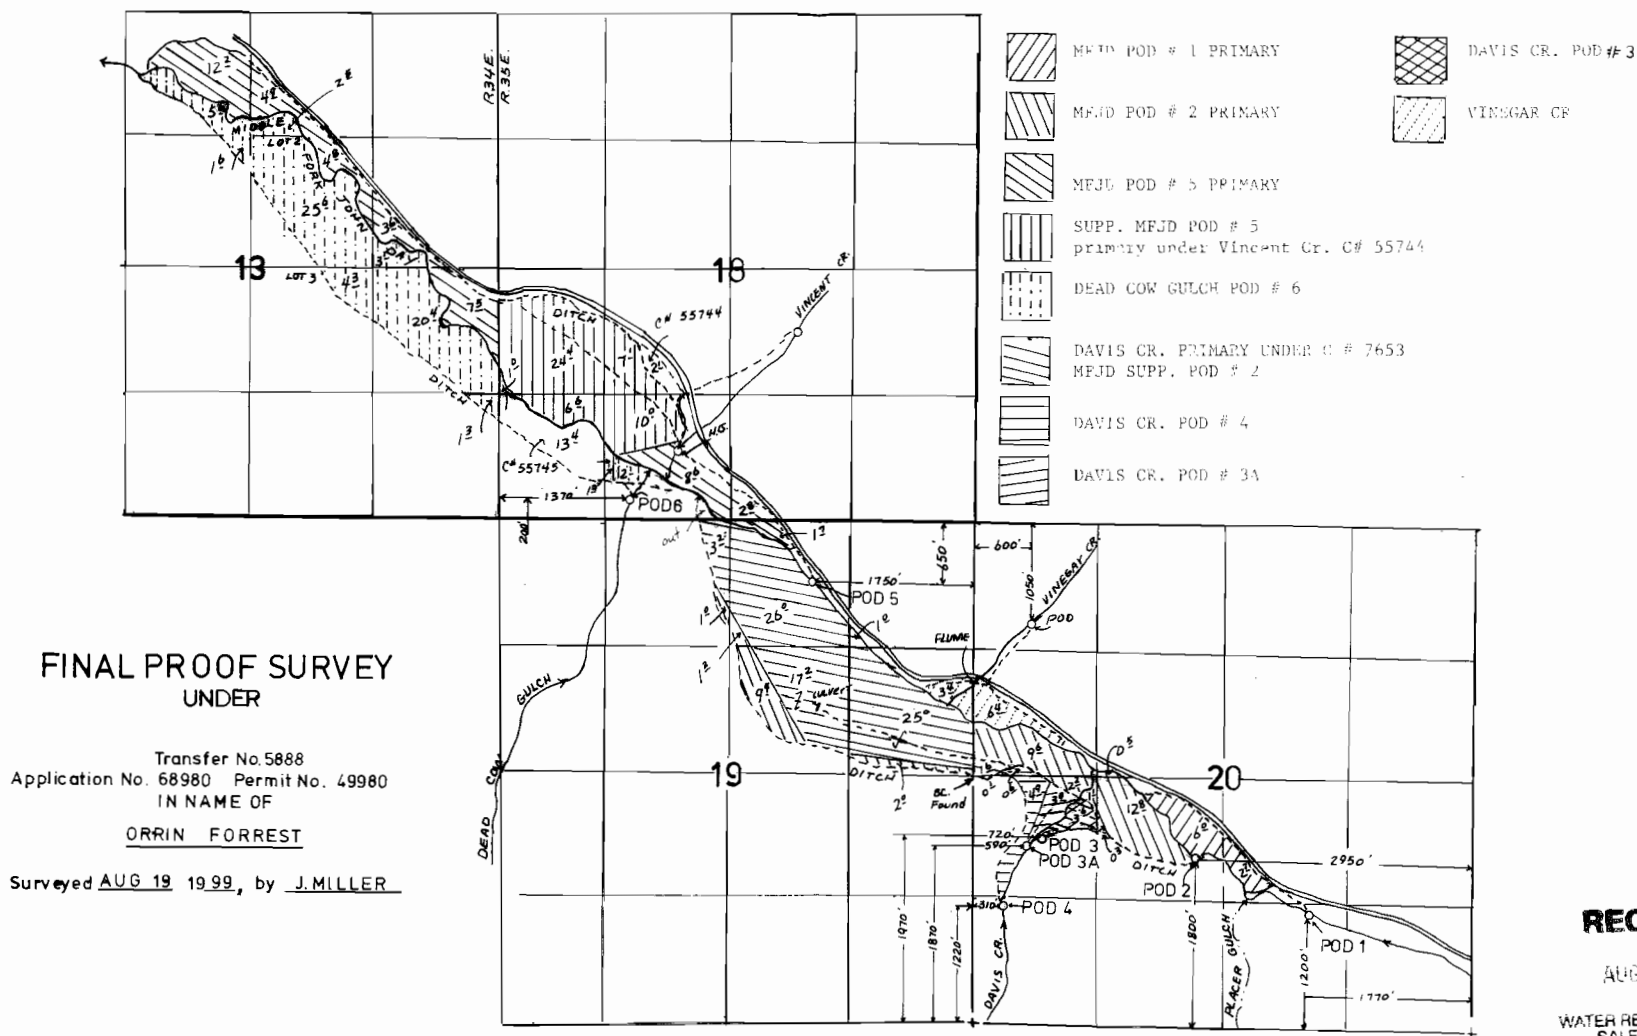

J.M. 4-21-00

USDA-F 12 616040A 289-22, 1189-226
NAPP 7027 804, 80R, 81R.