Township 11 South, Ranges 34 and 35 East, W.M.

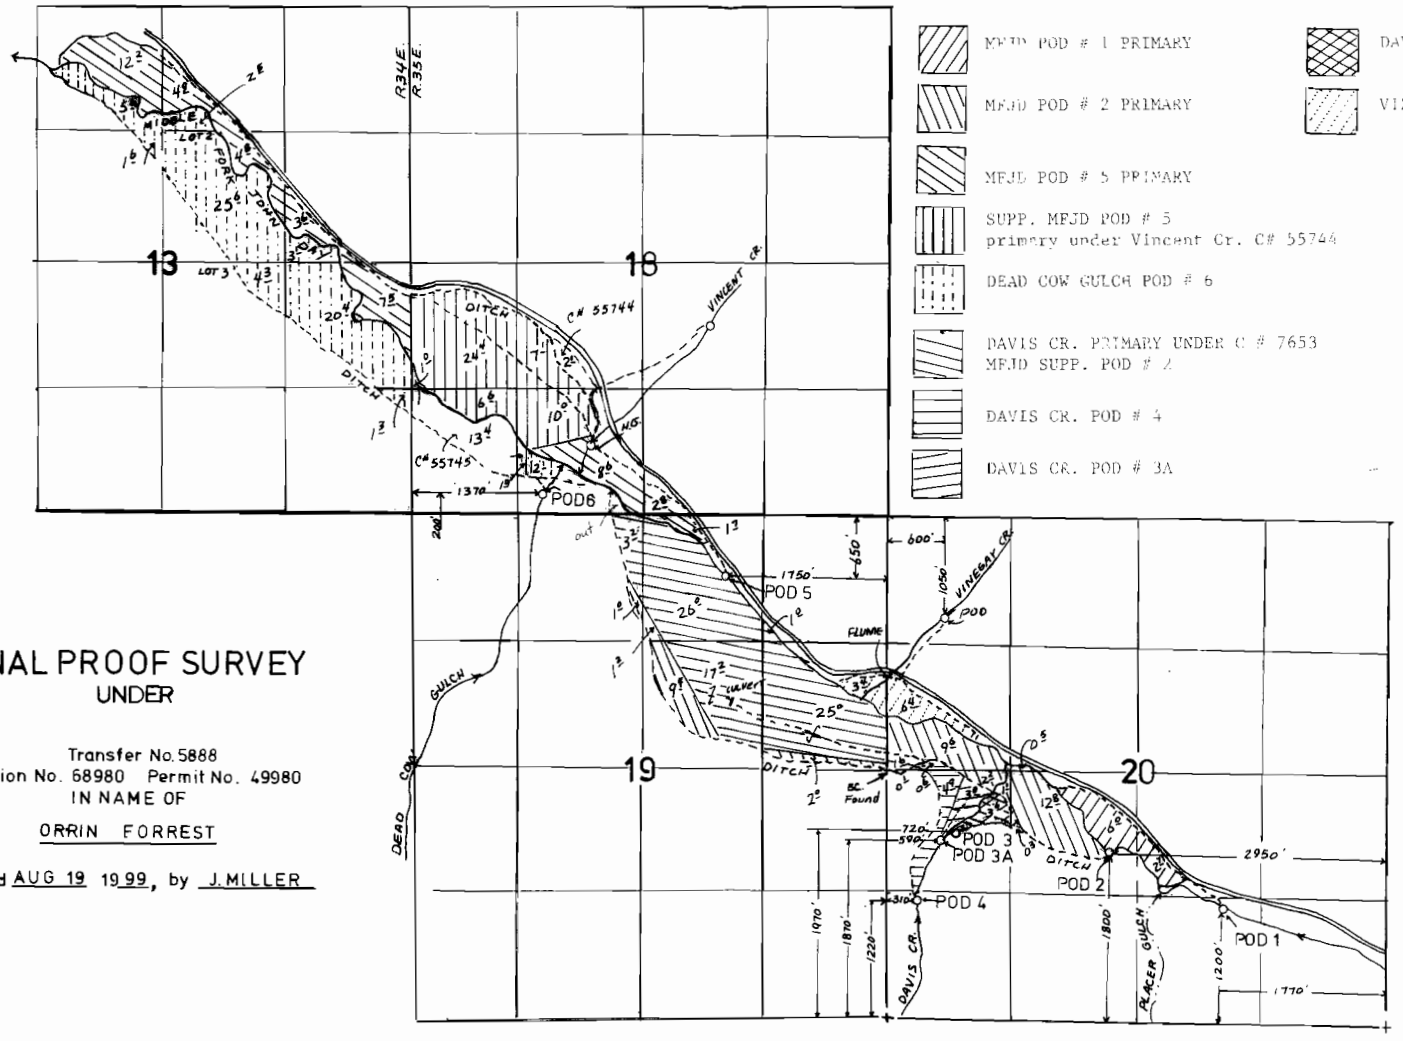

FINAL PROOF SURVEY
UNDER

Transfer No. 5888
Application No. 68980 Permit No. 49980
IN NAME OF

ORRIN FORREST

Surveyed AUG 19 1999, by J. MILLER

RECEIVED
AUG 2000
WATER RESOURCES DEPT
SALEM OREGON

J.M. 4-21-00

USDA-F 12 6160 40A 289-22, 1189-226
NAPP 7027 80L, 80R, 81R.