


T. 13 S., R. 33 E., W.M.

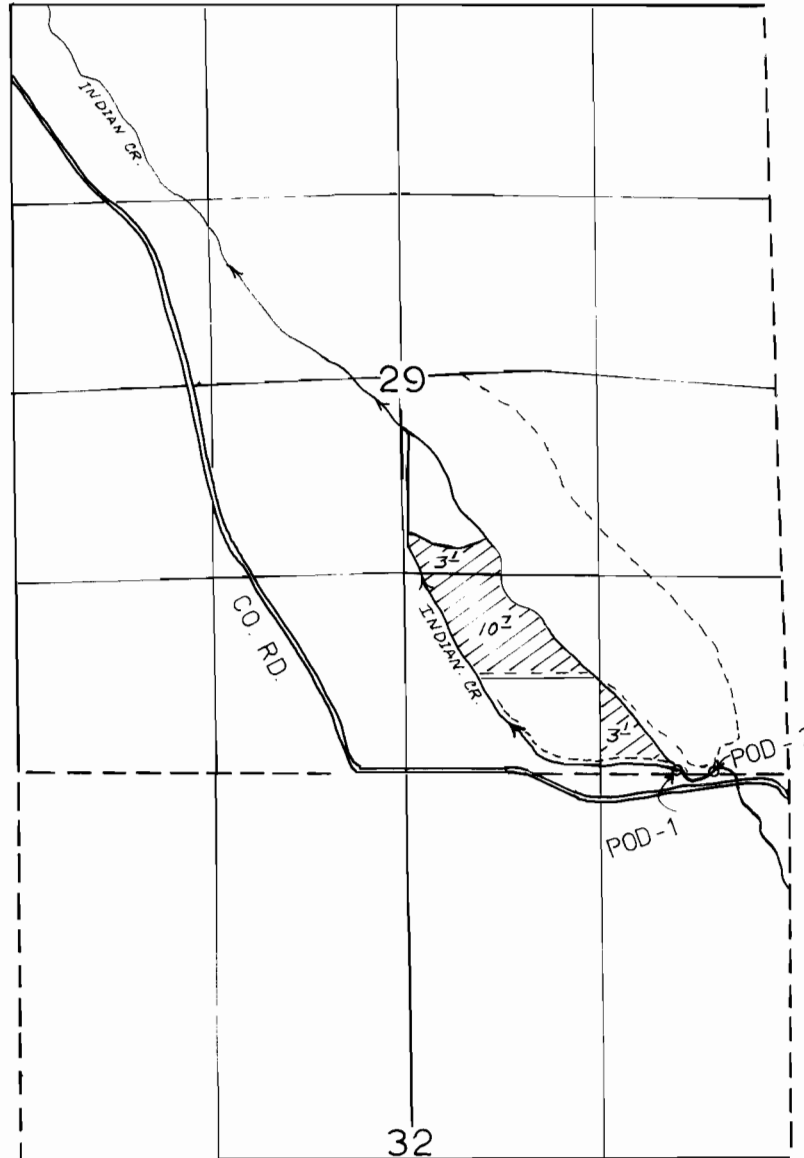

POD 1 - 10' N & 750' W. FROM THE S.E. COR. SEC. 29
POD 2 - 10' N & 540' W. FROM THE S.E. COR. SEC. 29.

FINAL PROOF SURVEY

UNDER

Application No. 60300 Permit No. 45105
IN NAME OF

J. A. AND SUSAN HEASTON

Surveyed 3/18, 1986, by L. TOLL