
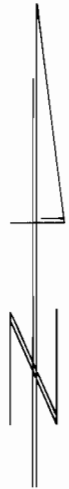


T12S, R26E, WM

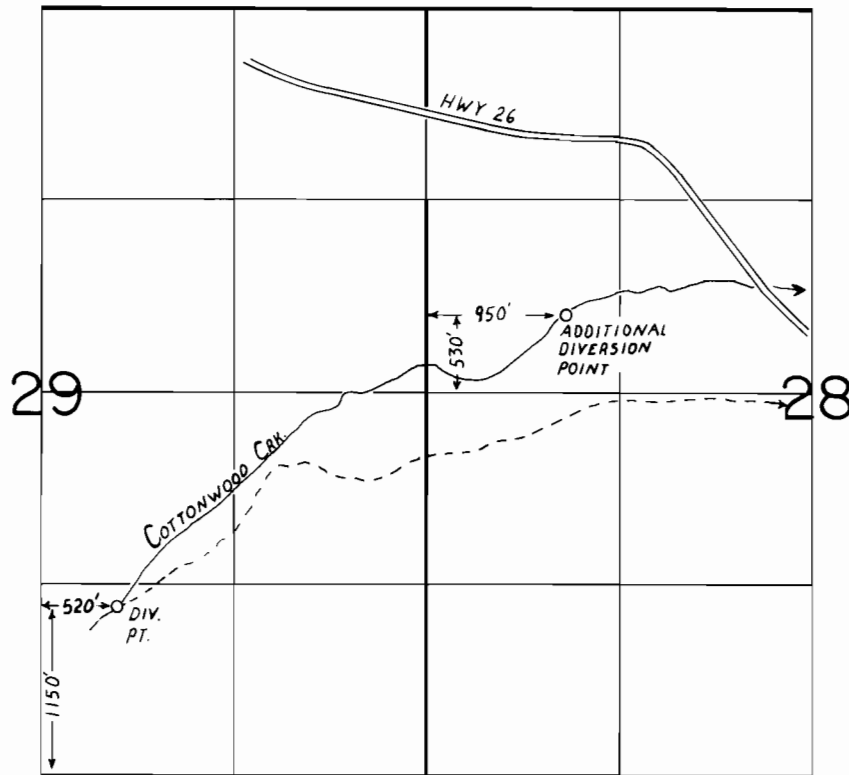

SCALE
1" = 1320'

FINAL PROOF SURVEY UNDER

Transfer No. 5056

Application No. Permit No.
IN NAME OF

PETER C. & BRENDA K. HETTINGA

Surveyed JUNE 18, 1988, by T.M. WARREN...