
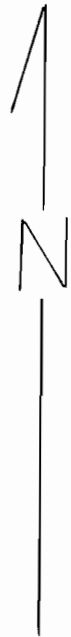


Township 10 & 11 S., Range 26 E., W.M.

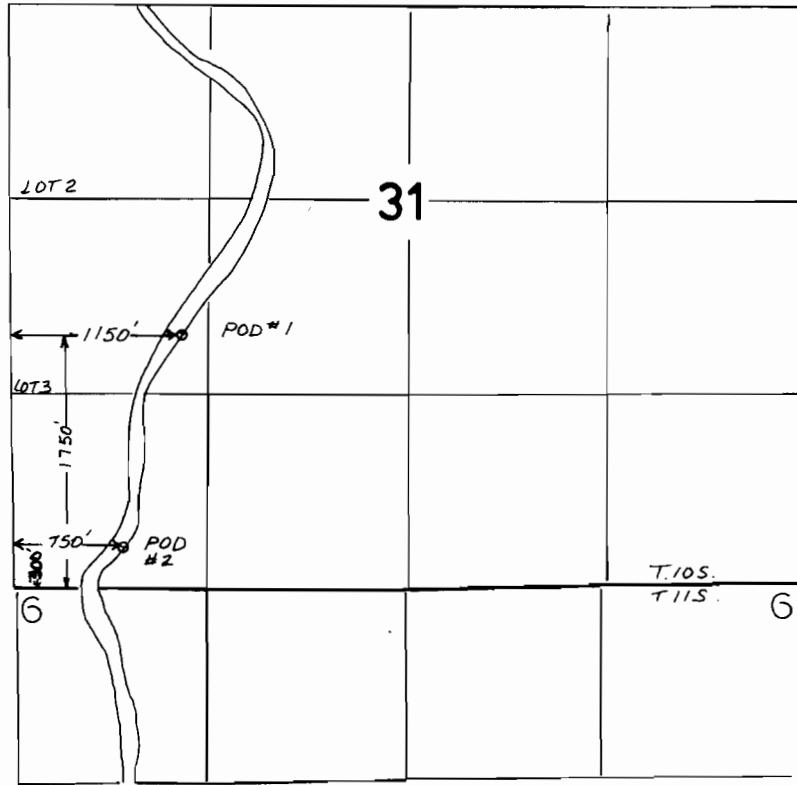

1"=1320'

FINAL PROOF SURVEY

UNDER

TRANSFER 5172

Application No. Permit No.

IN NAME OF

LEO E. & MARION JOHNSON.....

Surveyed Sept. 27... 1999., by J. Miller.....