

APPLICATION MAP

FOR

R.W. DONNELLY &
LINDA G. DONNELLY

RECEIVED

AUG 25 1986


WATER RESOURCES DEPT
SALEM, OREGON

Application No. 68837
Permit No. 49908

RECEIVED

NOV 4 1986

WATER RESOURCES DEPT.
NE SALEM, OREGON
Cor.

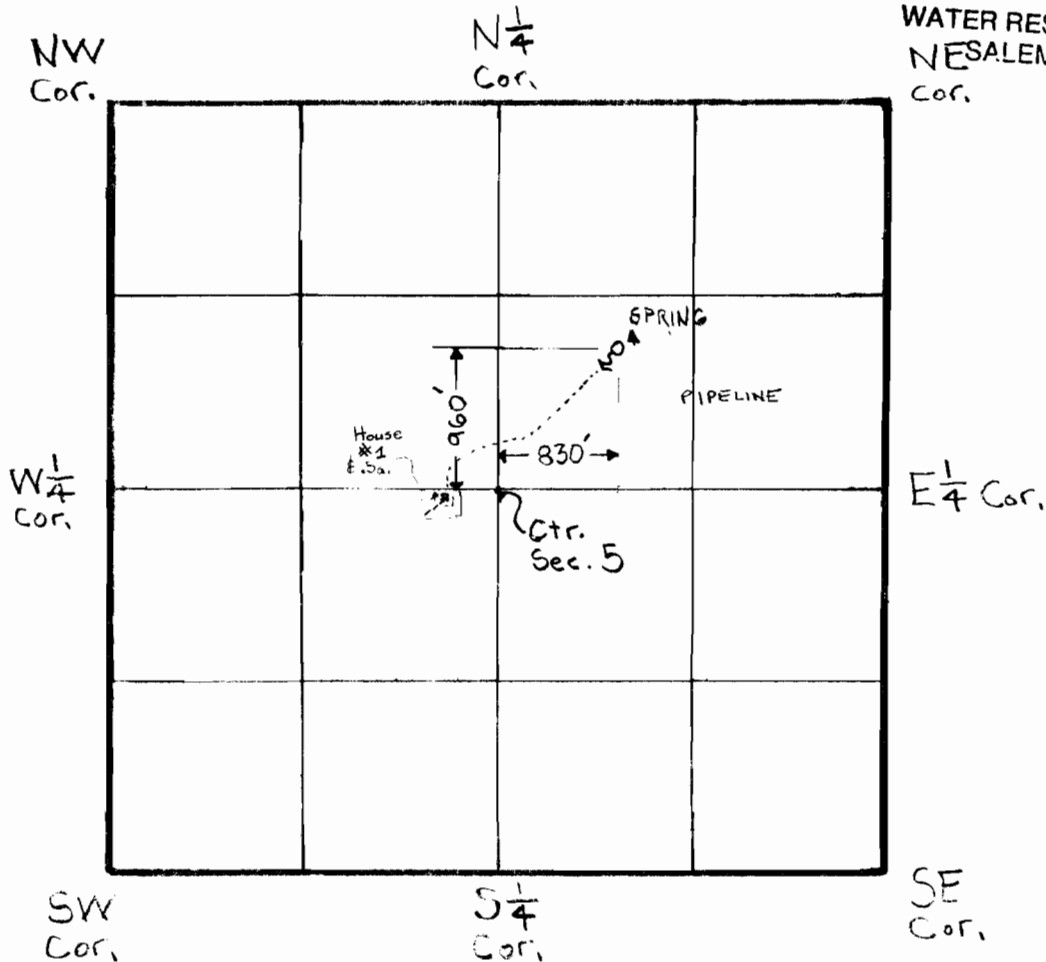

Sec. 5, T 10S, R 23E, W.M.

Scale 4" = 1 mile

Approved by: R.W. Donnelly, Linda Donnelly
8/21/86