




2 of 6

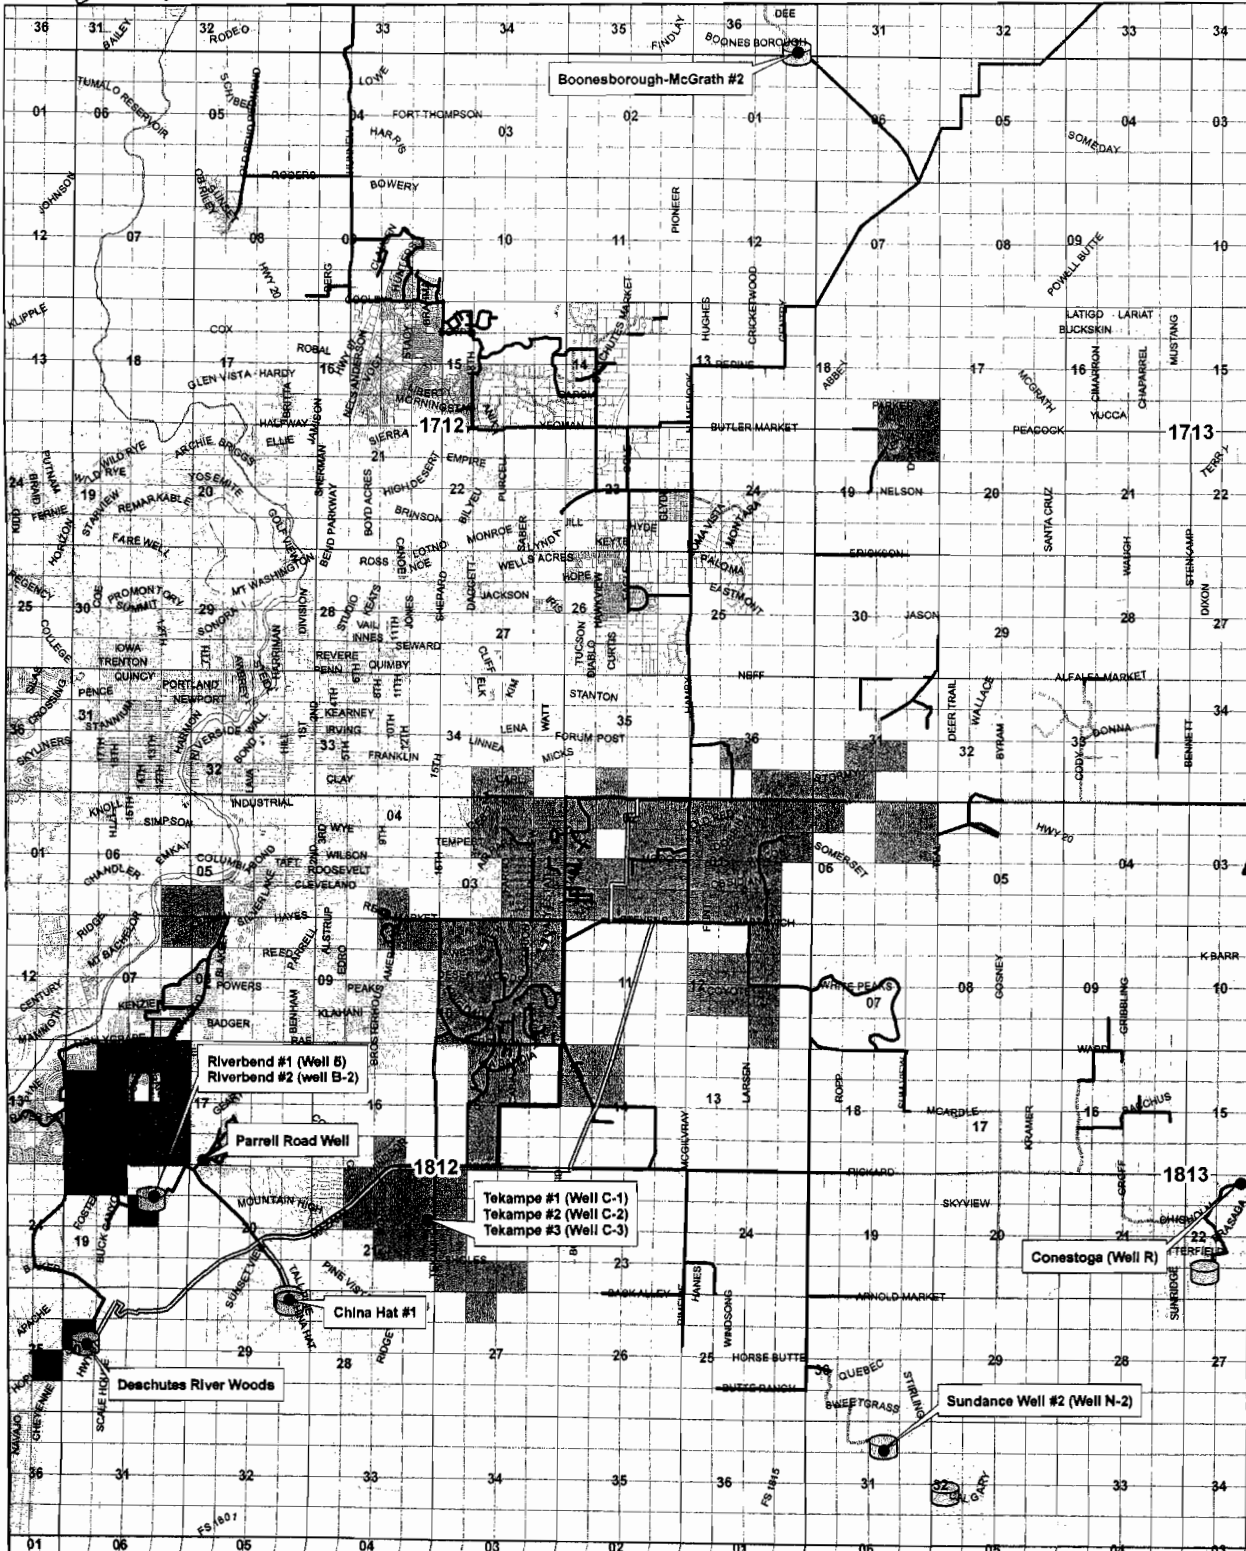

1 inch equals 5,280 feet
0 2,500 5,000 10,000 Feet

DRAWN BY: TANNER LEMMON
AVION WATER GIS DEPARTMENT
JUNE, 2006

PLACE OF USE	
	PERMIT (G-9217)
	PERMIT (G-9269)
	PERMIT (G-9320)
	PERMIT (G-9946)
	PERMIT (G-9948)
	PERMIT (G-9975)
	PERMIT (G-9976)

DISCLAIMER:
This map was prepared for the purpose of identifying the location of water rights only and is not intended to provide legal dimensions or locations of property ownership lines.

	24-dom		12-dom		4-dom
	20-dom		10-dom		3-dom
	18-dom		8-dom		2-dom
	16-dom		6-dom		
	14-dom		5-dom		
	Points of Appropriation		Storage		

AVION WATER CO, INC.


SUPPLEMENTAL CLAIM OF BENEFICIAL USE - PLACE OF USE MAP

Attachment 5


T-7779 / Permit G-9320

3 of 4

0209
5080

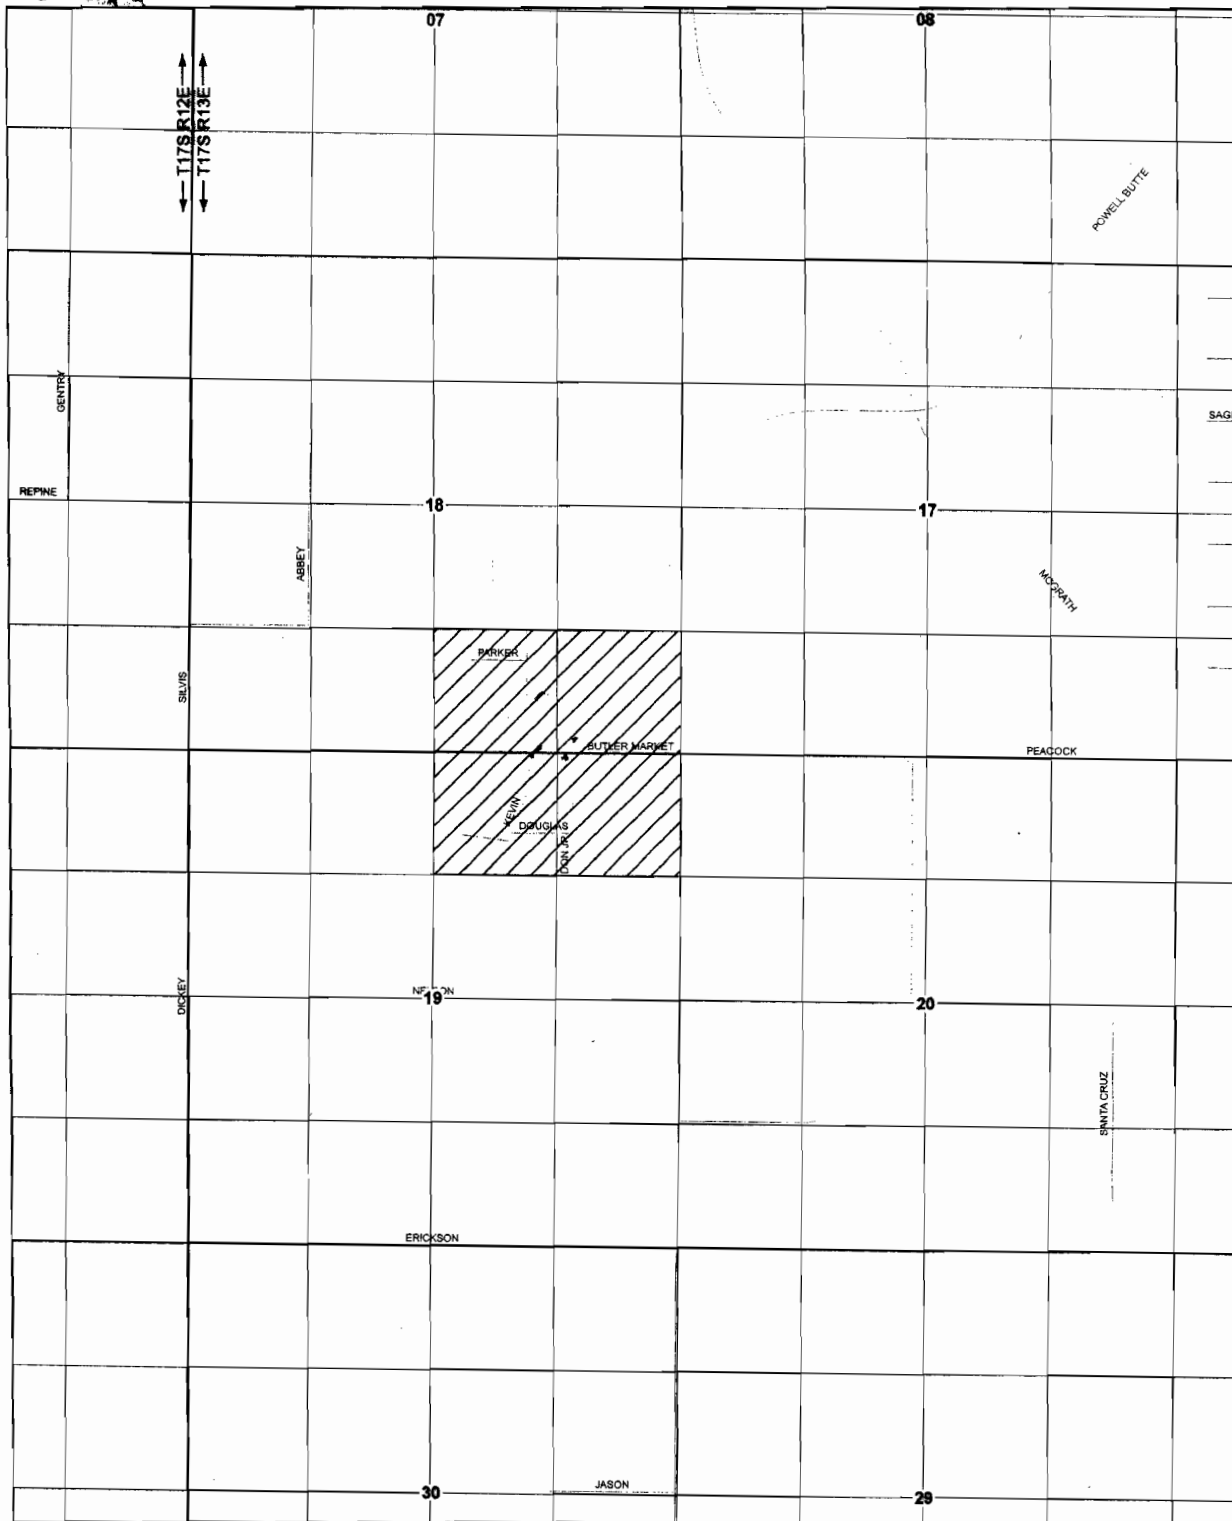

1 inch equals 1,320 feet

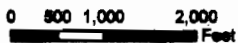

DRAWN BY: TANNER LEMMON
AVION WATER GIS DEPARTMENT
CWRE: TERRY SPRECHER
JUNE, 2008

PERMIT G-9320

DISCLAIMER:
This map was prepared for the purpose of identifying the location of water rights only and is not intended to provide legal dimensions or locations of property ownership lines.



RECEIVED
JUN 22 2008

WATER RESOURCES DEPT
SALEM, OREGON

NOTES:
- Please refer to "Attachment 1" for location of Distribution Piping
- Please refer to "Attachment 2" for Point of Appropriation locations