


# T.13&14 S.R.5 W.W.M.

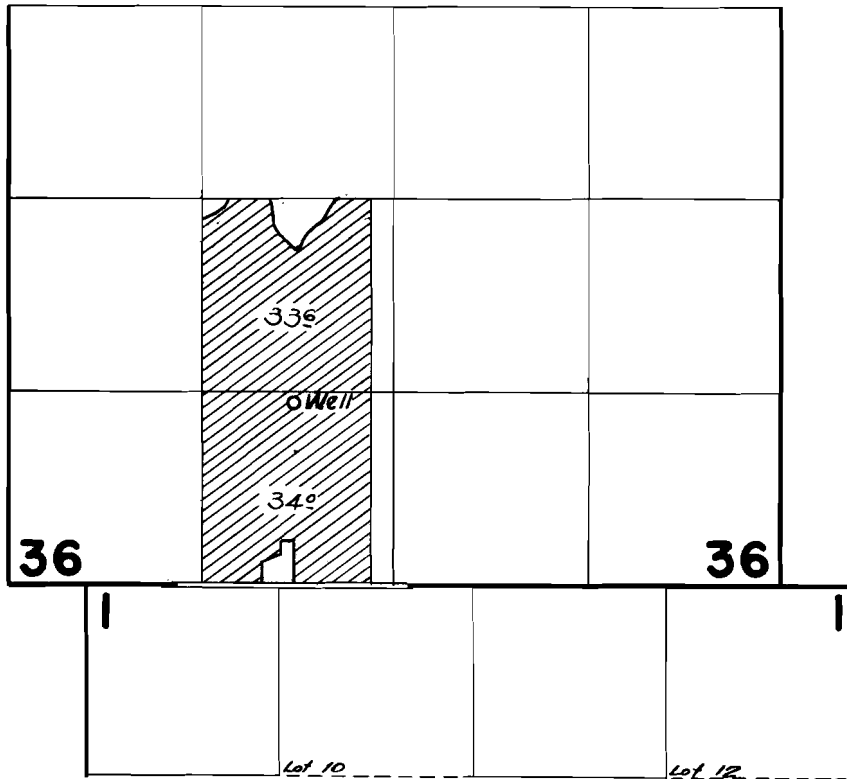


## FINAL PROOF SURVEY UNDER

Application No. **G-2027**. Permit No. **G-1865**.  
IN NAME OF

**IVAN M. HORNING**

Surveyed *April 24* 1963, by *C. Baker*

# T 13 & 14 S, R 5 W, WM

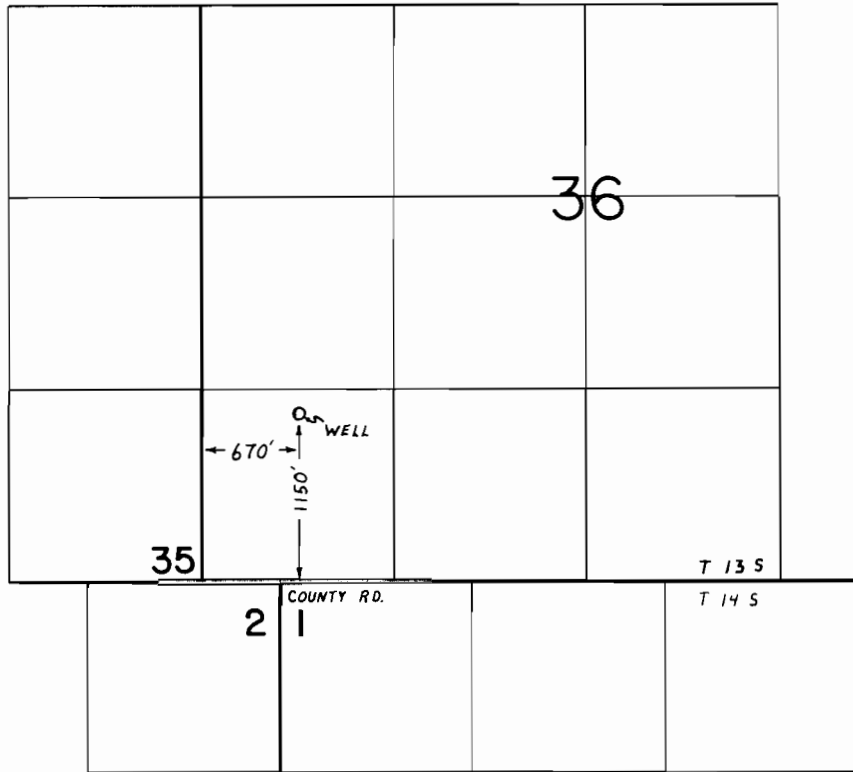

SCALE  
1" = 1320'

## FINAL PROOF SURVEY UNDER

Transfer No. ...5264....  
 Application No. .... Permit No. ....  
 IN NAME OF

.....IVAN M. HORNING.....

Surveyed NOV. 30, 1987., by T.M. WARREN...