


T. 3 S. R. 2 W. W. M.

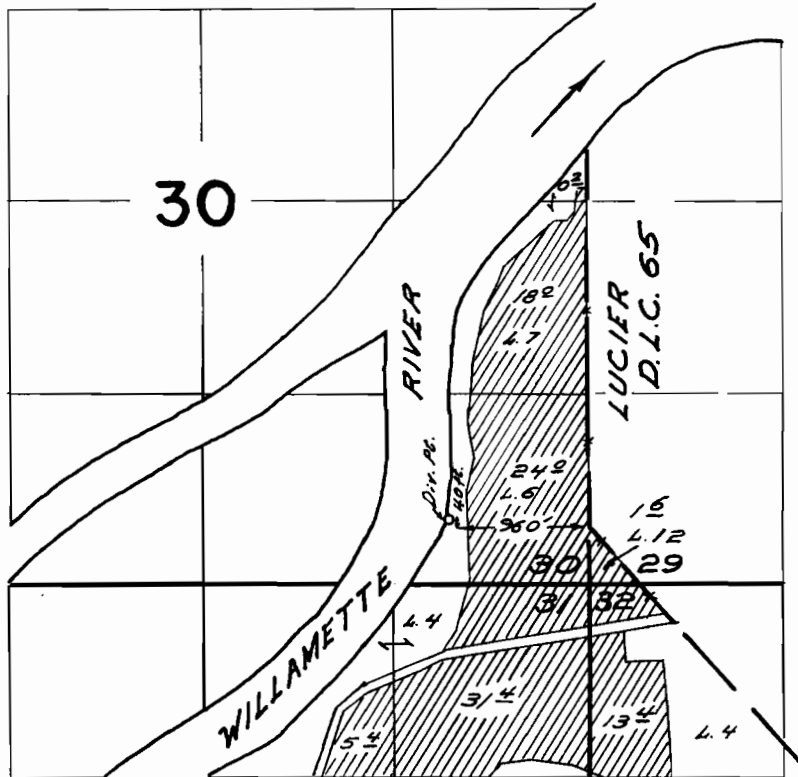

FINAL PROOF SURVEY
UNDER

Application No. 37807 Permit No. 28198
IN NAME OF

MILTON M. WOLSBORN

Surveyed April 5, 1967, by W. J. Ruppert