




TITLE MAP

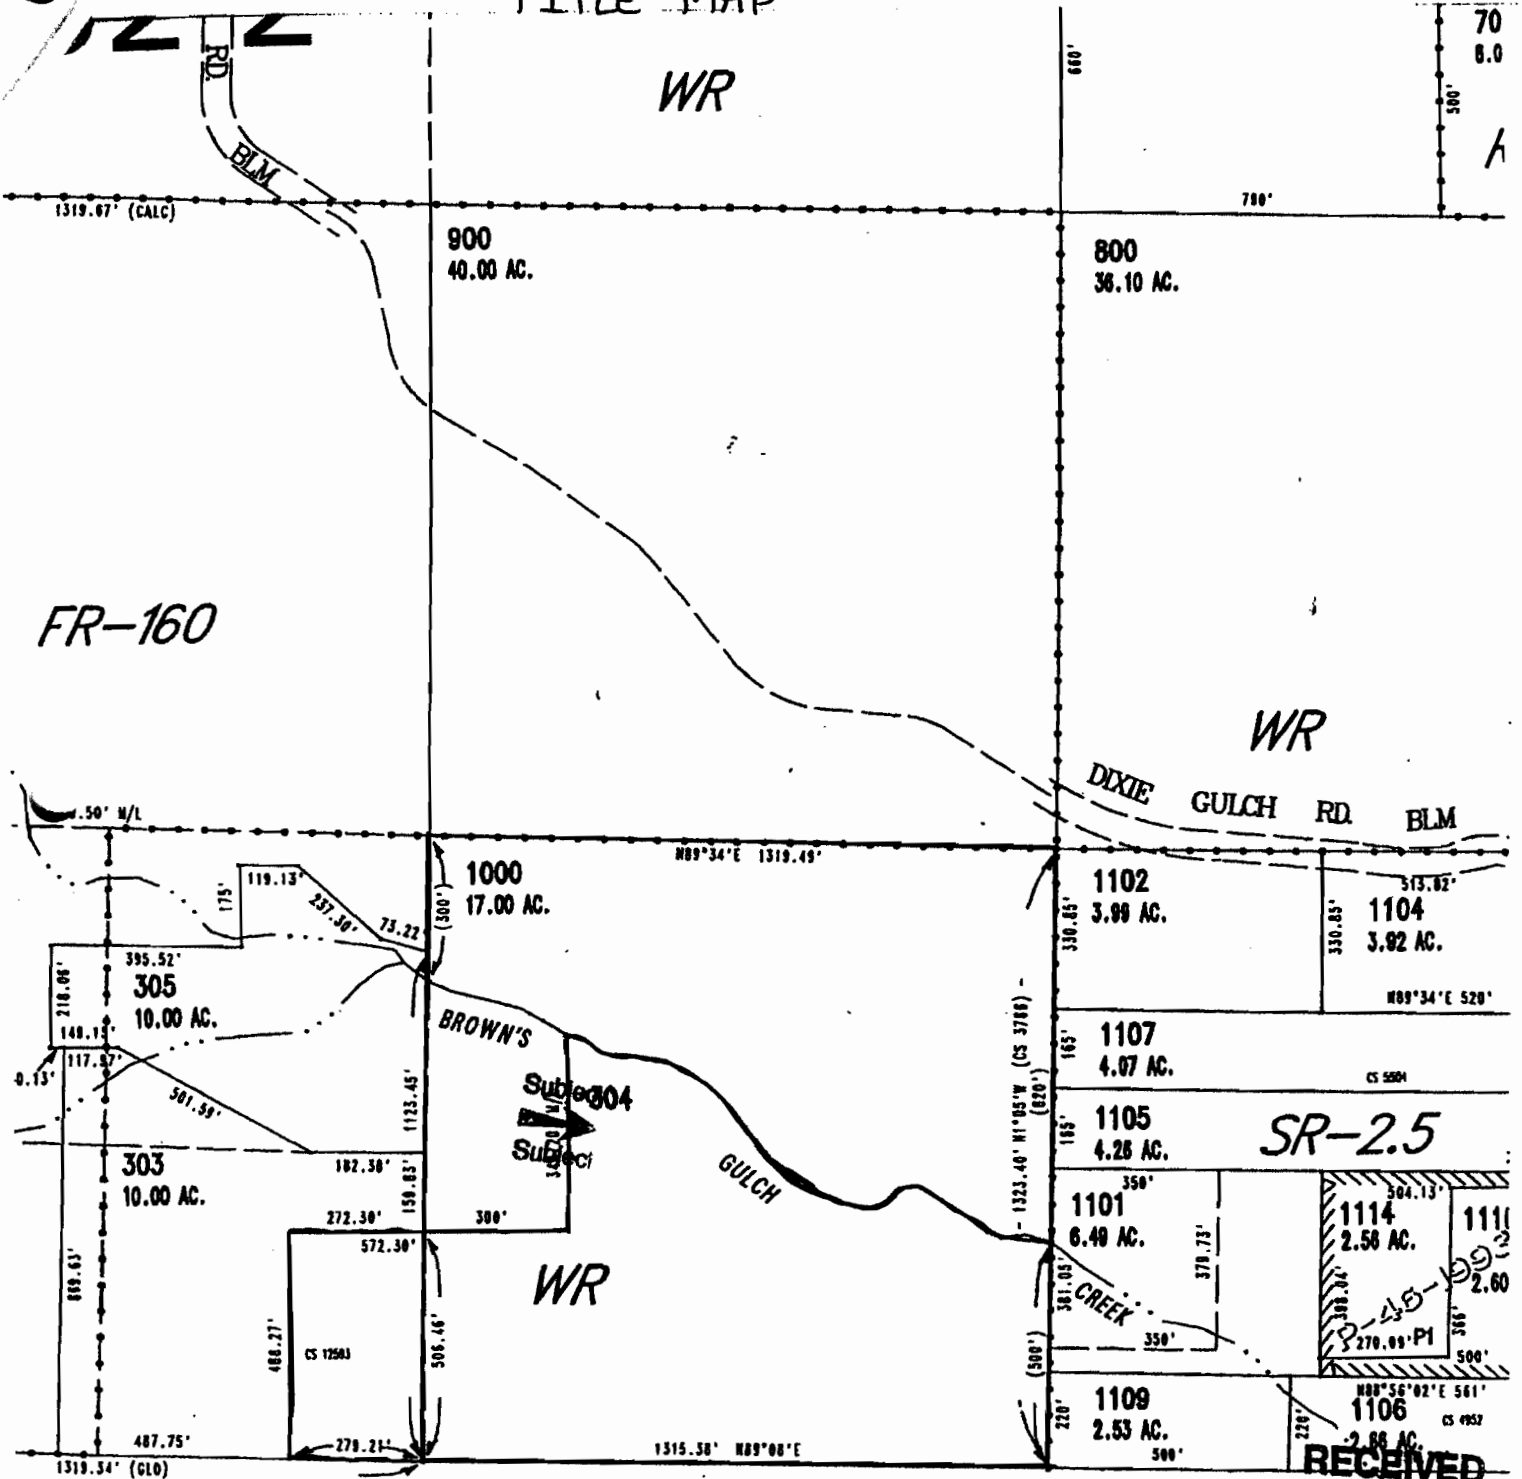

SCALE 1/4" = 100'

SEE MAPP 35 4W 8

RECEIVED  
JAN 06 2006  
WATER RESOURCES DEPT  
SALEM, OREGON


Twp. 35 R 4W sec. 05 SW 1/4 - SE 1/4

This print is made solely for the purpose of assisting in locating said premises, and the Company assumes no liability for information printed on this map, including zoning, variations (if any) in actual

MAP TO ACCOMPANY APPLICATION FOR  
MICRO-HYDROELECTRIC LICENSE

V.F. CALDWELL

DEC 2005

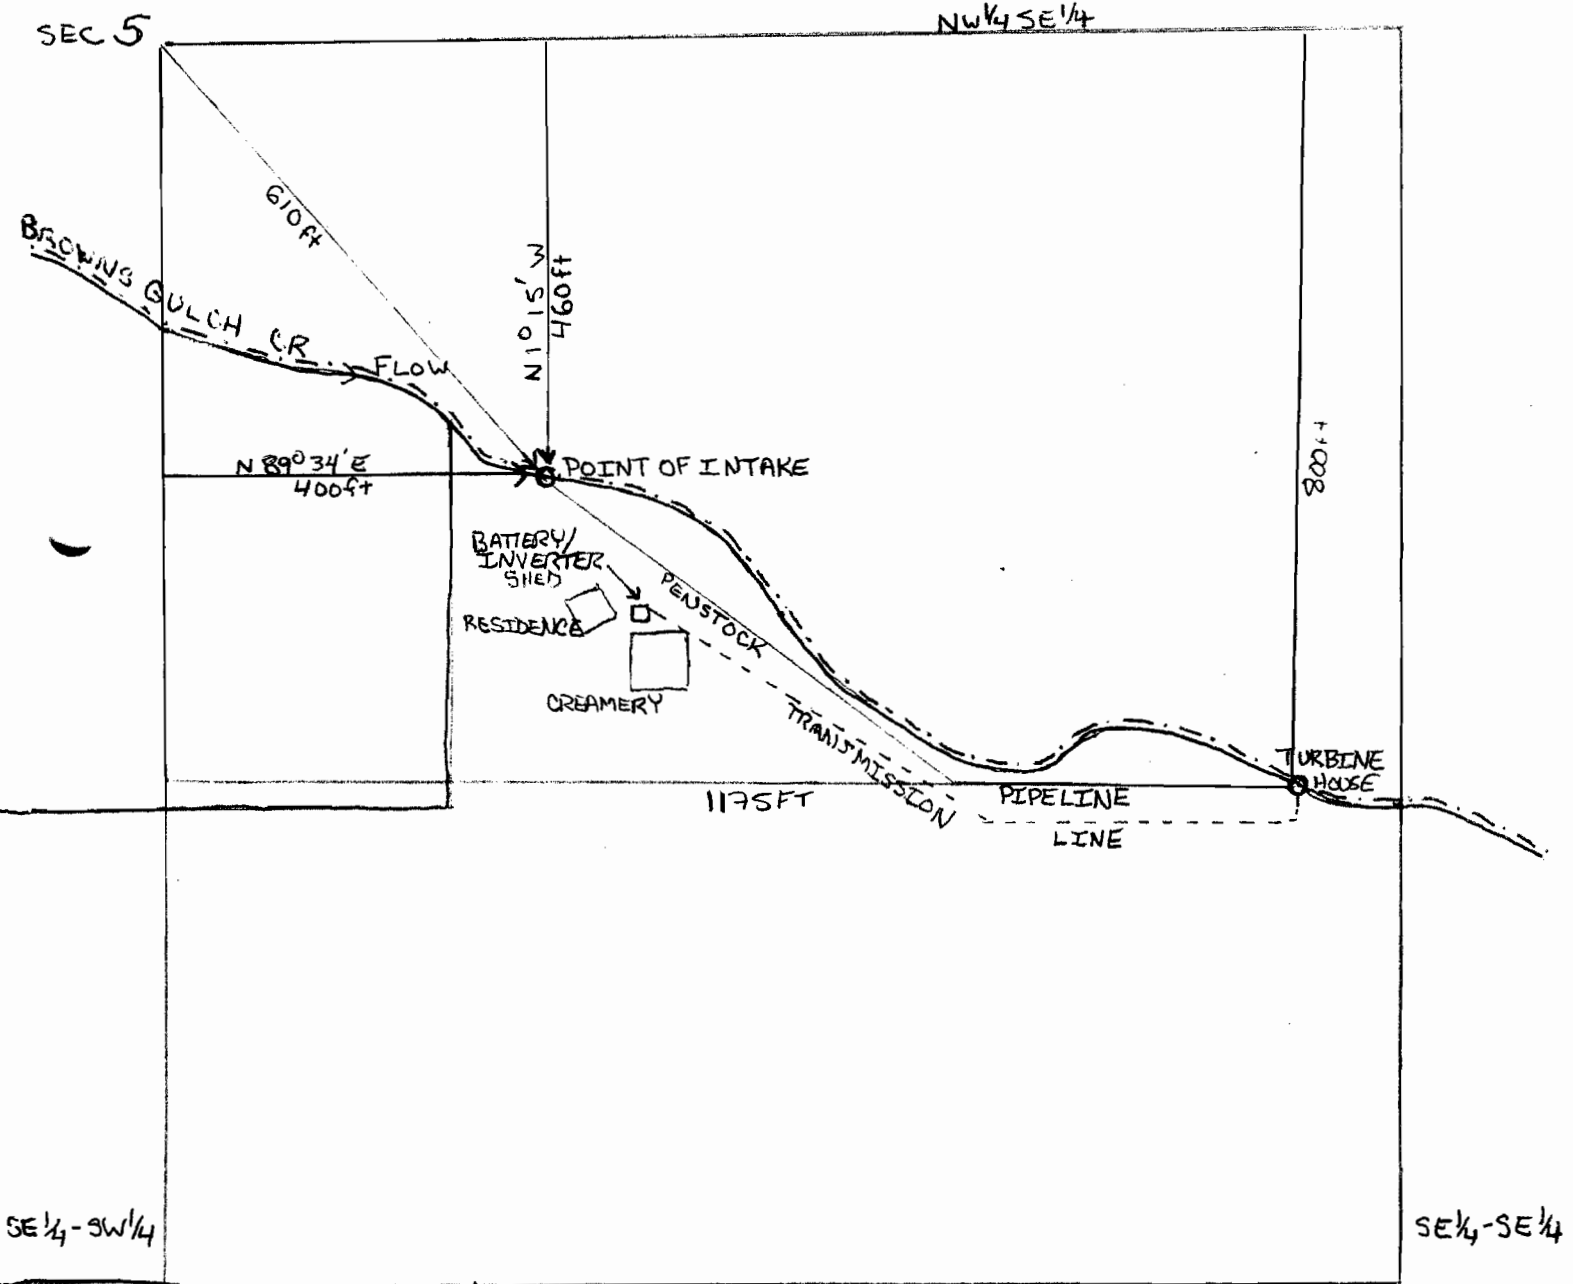

SECT 8

SCALE 1/4" = 50'

T 35 R 4W S 05 SW 1/4 - SE 1/4



RECEIVED

JAN 06 2006

WATER RESOURCES DEPT  
SALEM, OREGON