


T. 23 & 24 S., R. 38 E., W. M.

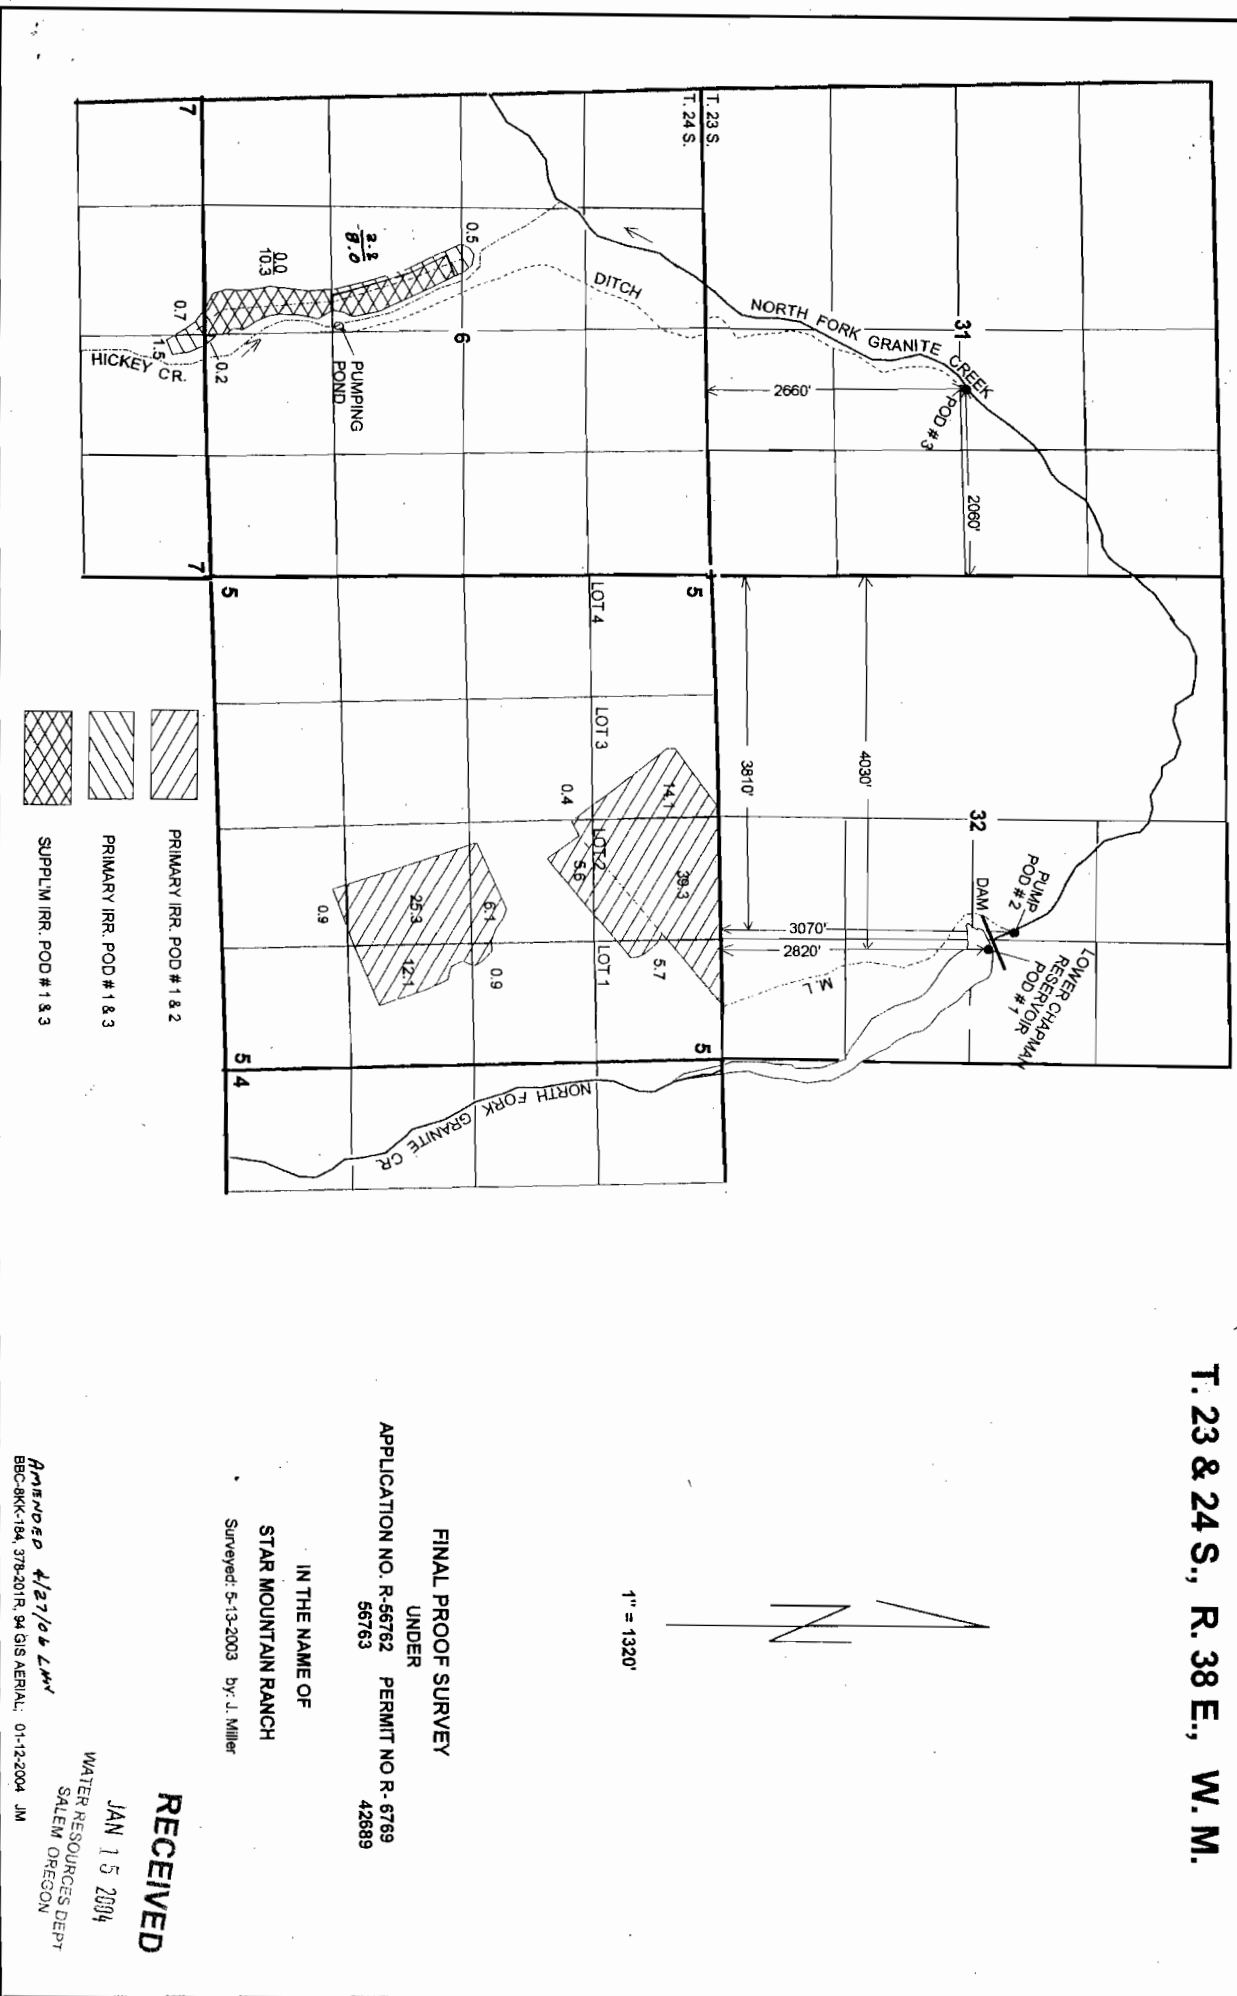

FINAL PROOF SURVEY

UNDER

APPLICATION NO. R-56762 PERMIT NO R-6769
56763 42689

IN THE NAME OF

STAR MOUNTAIN RANCH

Surveyed: 5-13-2003 by J. Miller

RECEIVED

JAN 15 2004

WATER RESOURCES DEPT
SALEM OREGON

Amended 4/27/06 LMM
BBC-8KK-184, 378-201R, 94 GIS AERIAL, 01-12-2004 JM