


T. 4N., R. 29E., W. M.

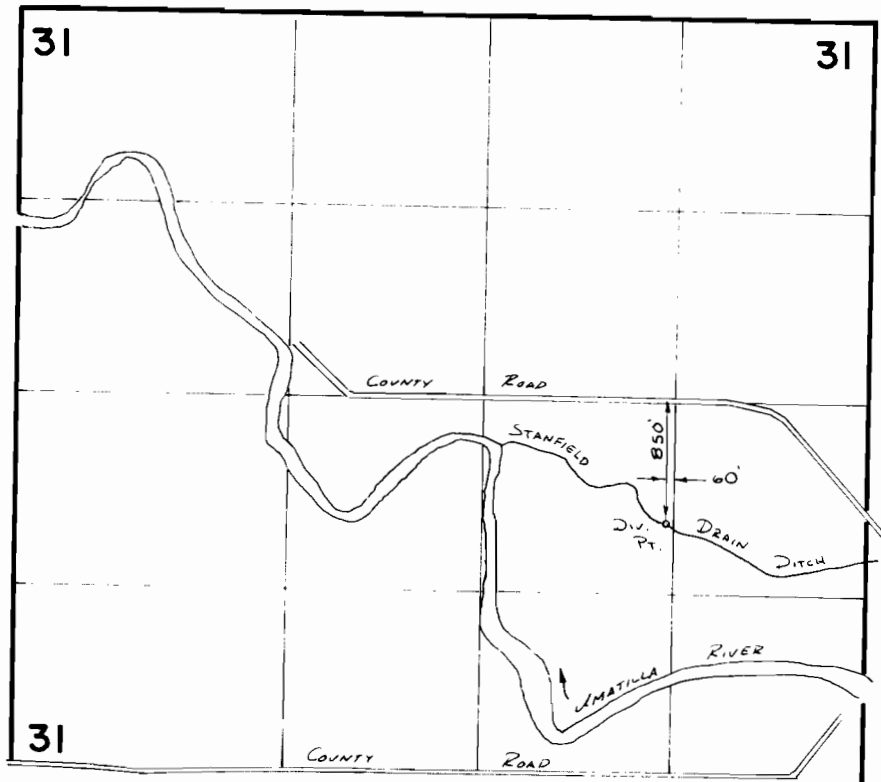

FINAL PROOF SURVEY

UNDER

TRANSFER 5369

IN NAME OF

WENDELL LAMPKIN

Surveyed *11/11/38* 19*38*, by *J. C. ...*



SCALE 1" = 1020'