


T. 13S., R. 29E., W. M.

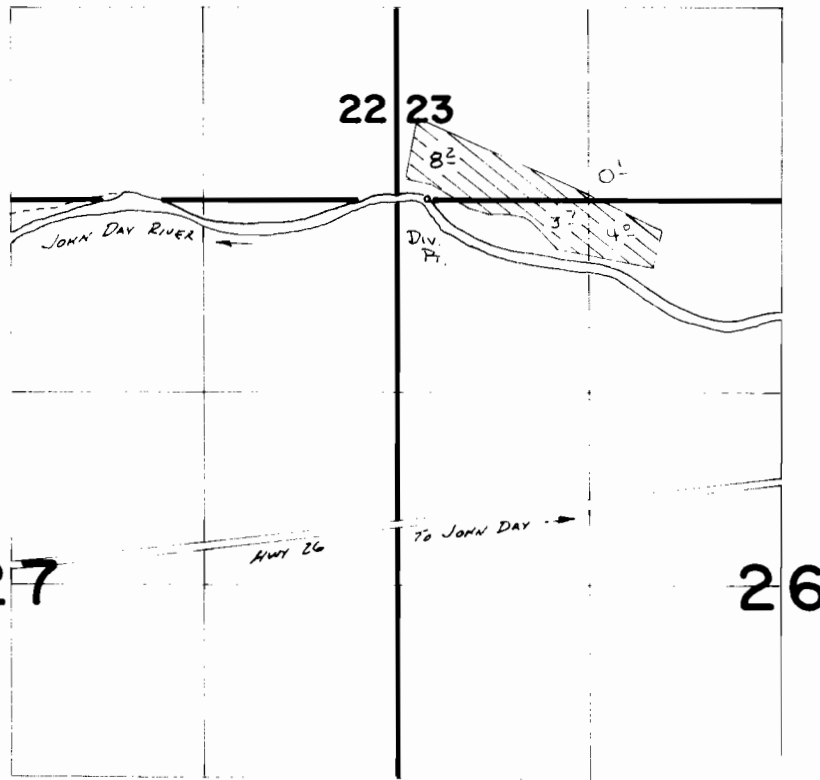

SCALE 1" = 1320'

Div. Pt. Loc: 10' N. & 210' E. From SW COR. Sec 23

**FINAL PROOF SURVEY**  
UNDER

**TRANSFER 5396**

IN NAME OF

**BROKEN LEG RANCH**

Surveyed 4-9-1986, by V. L. Church