


T. 10 S., R. 23 E., W. M.

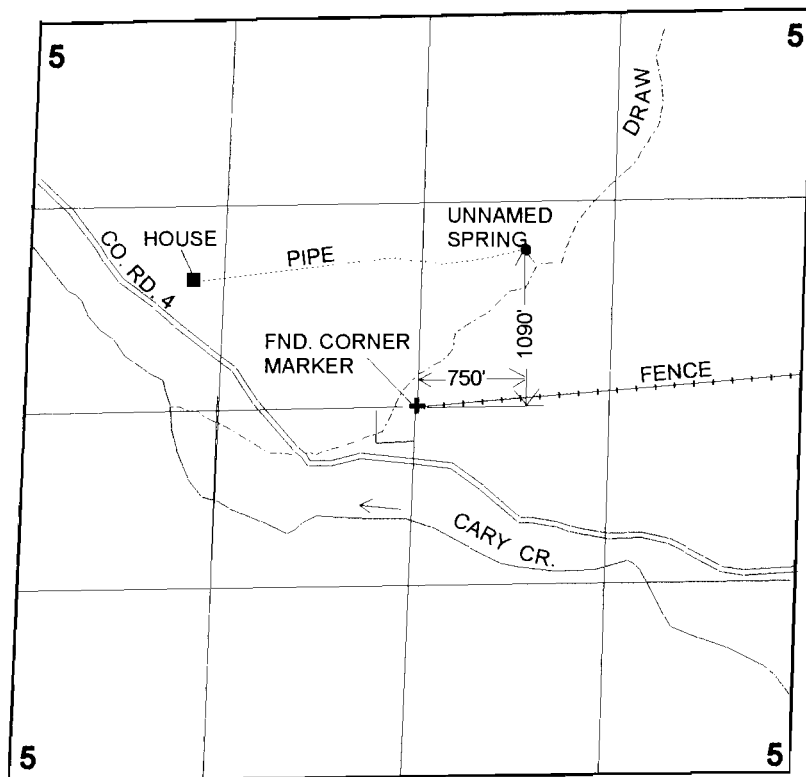

1" = 1320'

FINAL PROOF SURVEY

UNDER

Application No. 68857 Permit No. 49930

IN THE NAME OF

MARGARET DALE KEYS

Surveyed: May 08, 2001 by: J. Miller

RECEIVED

MAY 02 2003

WATER RESOURCES DEPT.
SALEM, OREGON