


RECEIVED
JUL 17 1985
WATER RESOURCES DEPT
SALEM, OREGON

J-5674

24	19
25	30

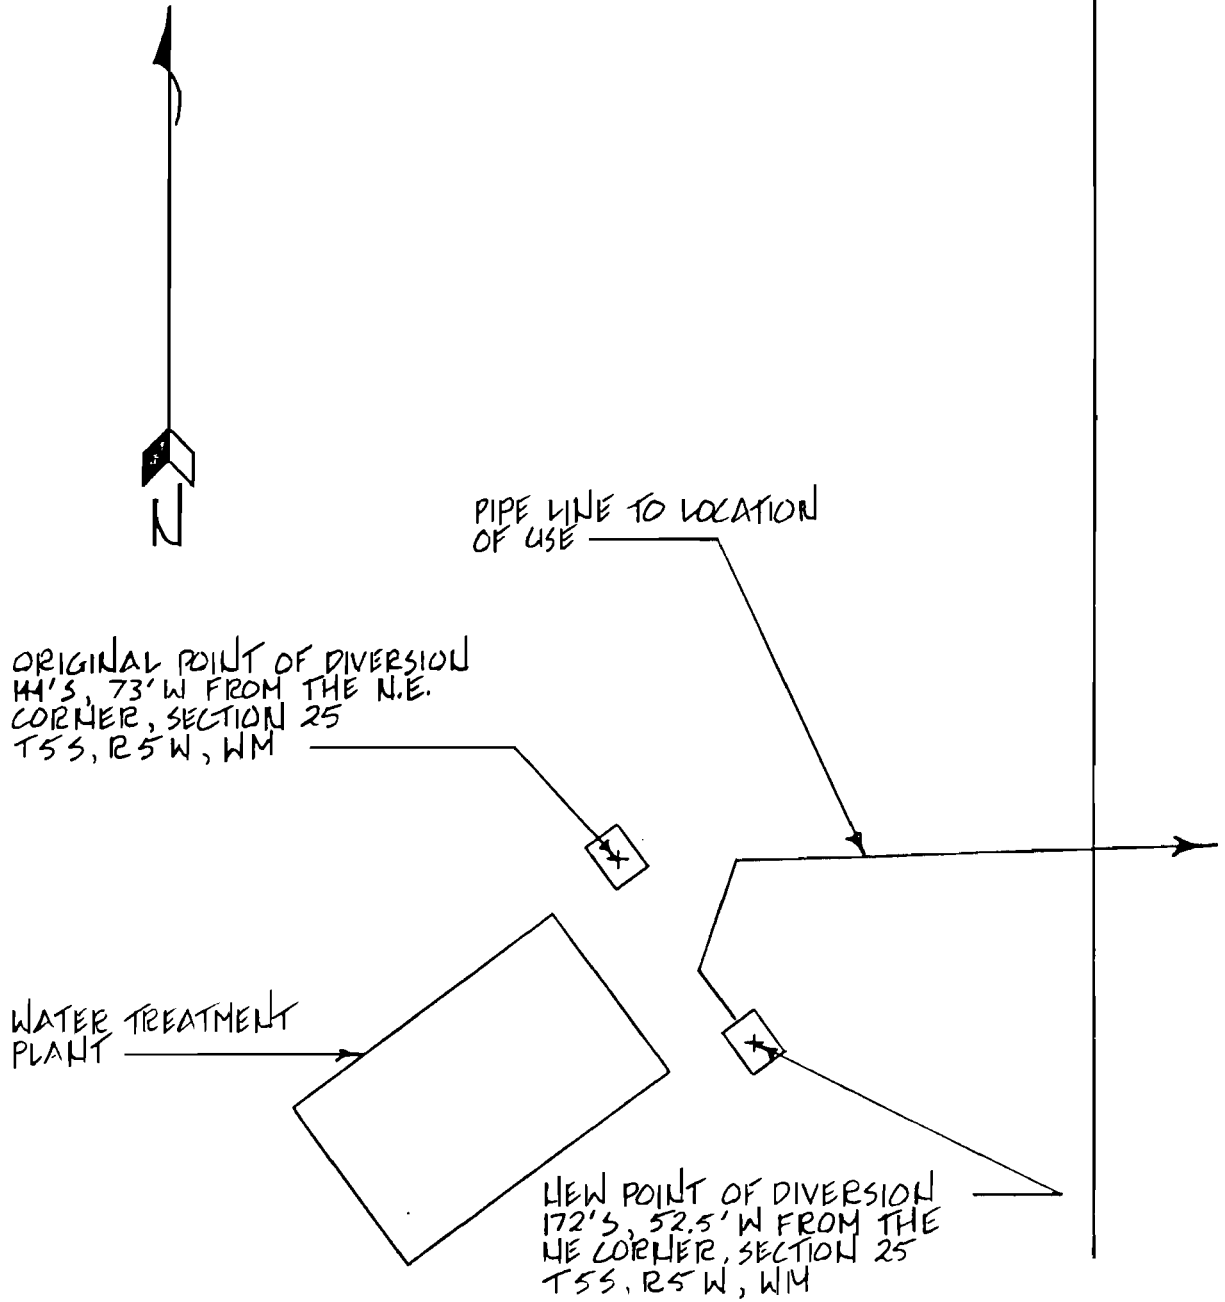


LOCATION OF DIVERSION

SCALE 1" = 30'

T-5674



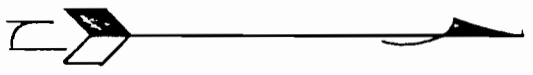

POINT OF
DIVERSION

PIPE LINE TO LOCATION OF USE

LOCATION OF USE
CITY OF AMITY

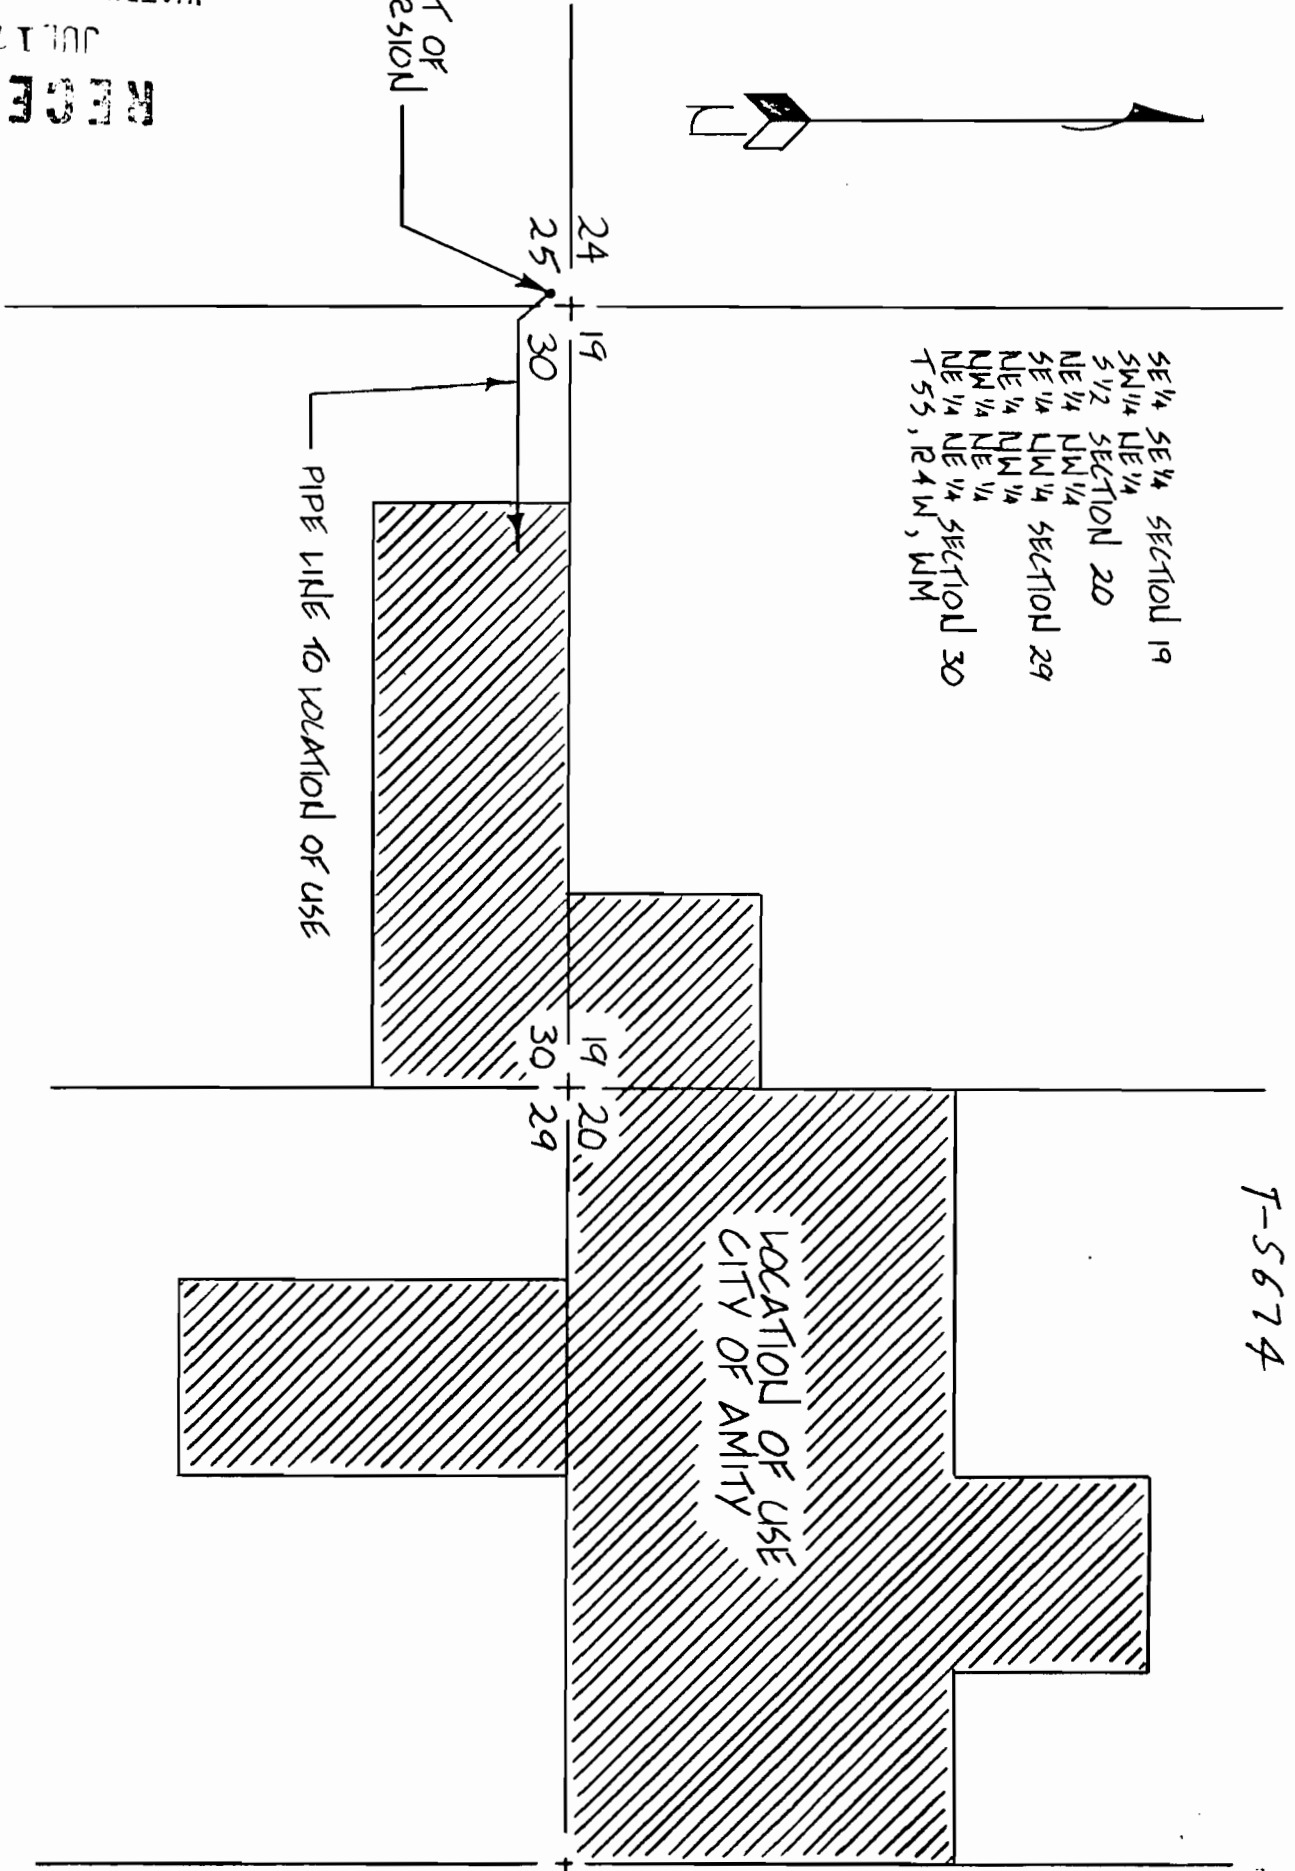

RECEIVED
 JUL 11 1985
 WATER RESOURCES DEPT
 SALEM, OREGON

LOCATION OF USE
 SCALE 4" = 1 MILE