


T.10S.,R.23E.,W.M.

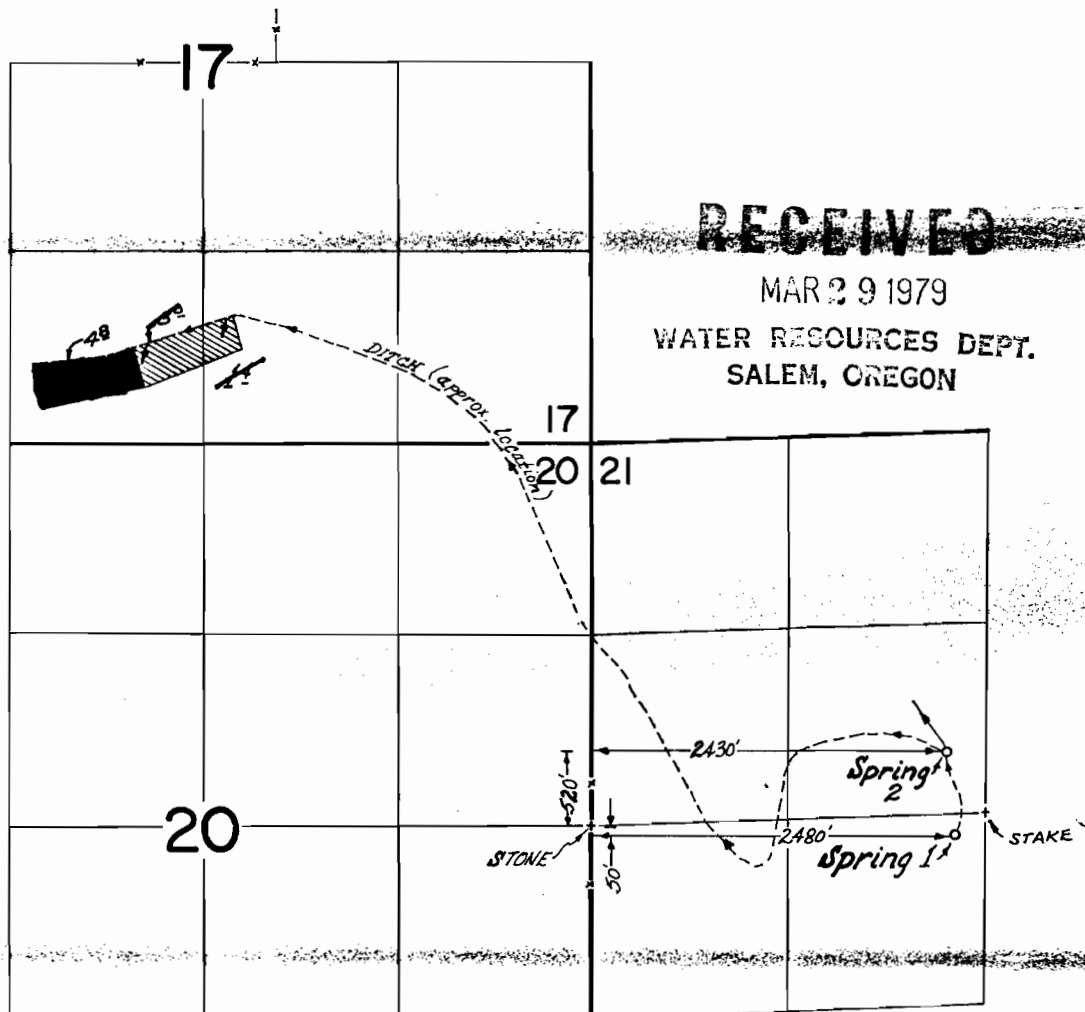

Application No. 58468
Permit No. 44044

~~FINAL PROOF SURVEY~~
UNDER

~~Application No. 46684 Permit No. 34599~~
IN NAME OF

~~CENTRAL OREGON FABRICATORS, INC.~~

~~Surveyed Aug 29 1977 by D.G. Muckler~~

1977-E AR