
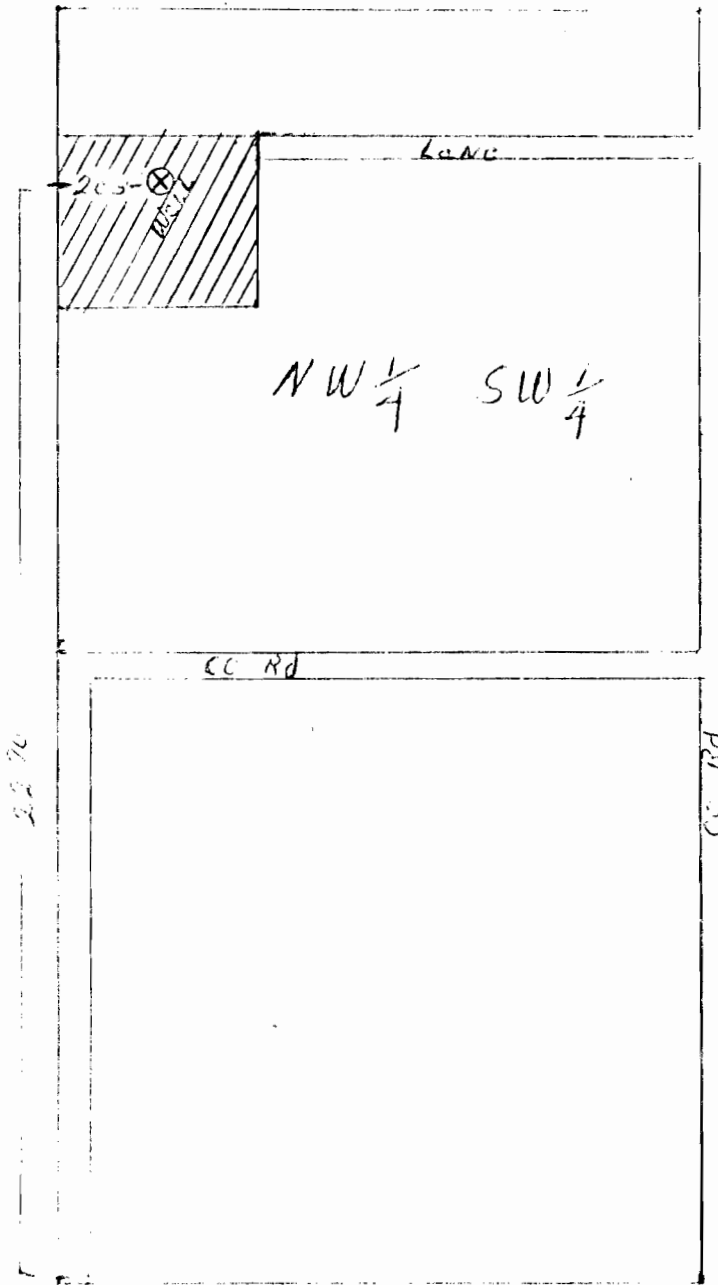



T 6 N R 36 E Sec 30

T-5503


1" = 400'

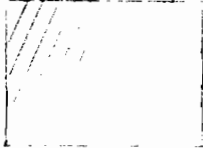


 Irrigated Area 3.2 ac

 Well

T. 6 N. R. 35 & 36 E. W.M.

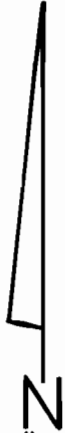

Scale 1" = 1320'

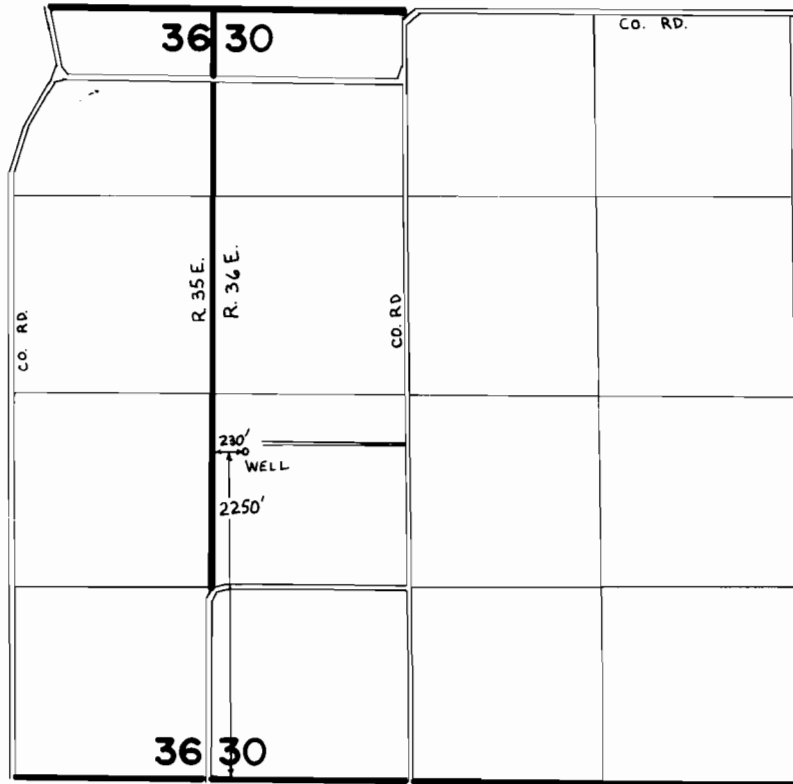

FINAL PROOF SURVEY UNDER

TRANSFER 5503

IN NAME OF

WAYNE HOCKETT

Surveyed March 16, 1987., by V. Church.....