


RECEIVED

AUG 4 1997


41023-129-72L  
J.M. 7-14-1997

# T. 13 S., R. 26 E., W.M.

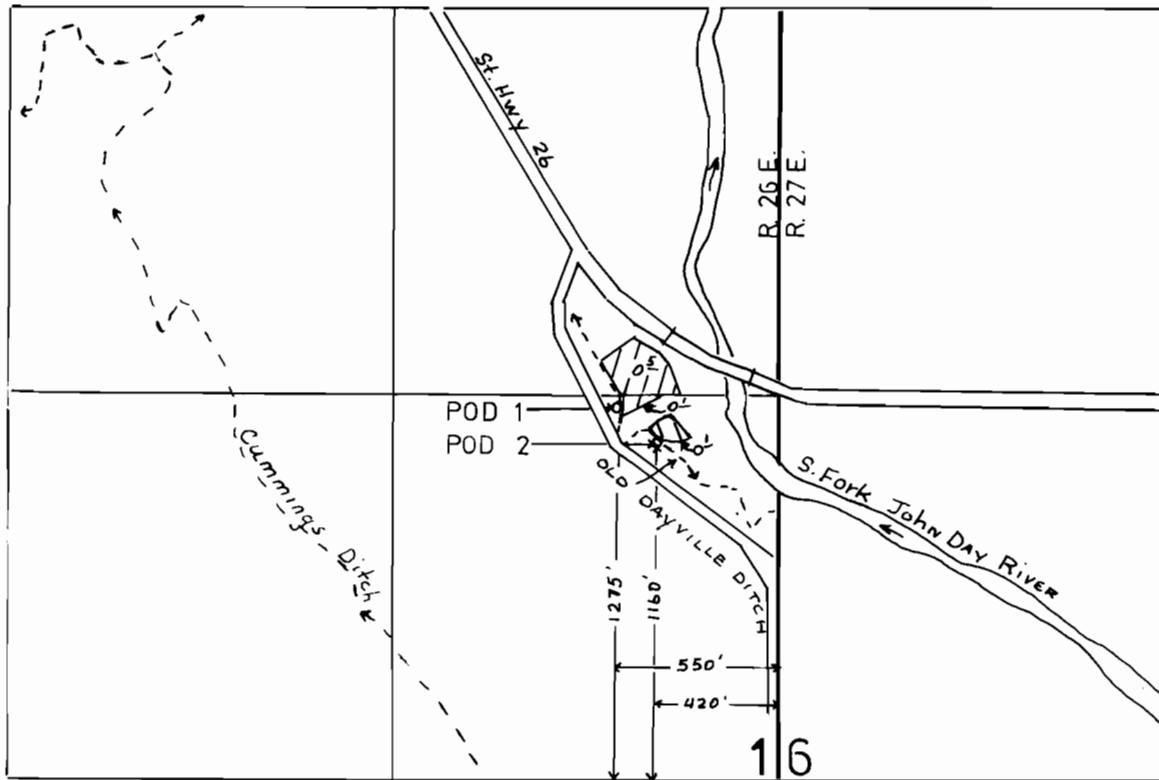

-  POD 1
-  POD 2

1" = 660'

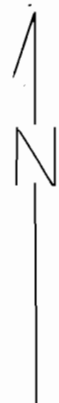

## FINAL PROOF SURVEY

UNDER

Application No. 61591 Permit No. 45712

IN NAME OF

RICHARD STEVEN THOMAS AND ETHEL JENNIVEA THOMAS

Surveyed SEPTEMBER 29, 1992, by J. MILLER