


Township 14 South, Range 32 East, W.M.

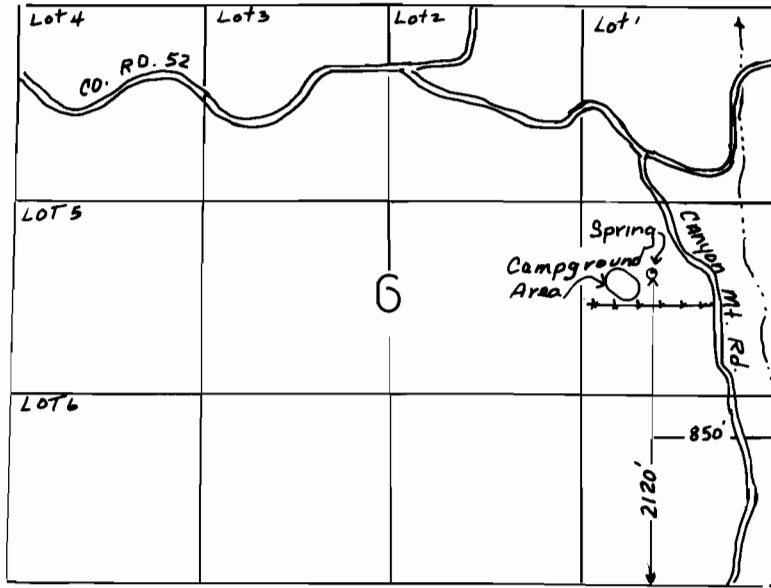

1" = 1320'

FINAL PROOF SURVEY UNDER

Application No. 51794.. Permit No. 39137.....
IN NAME OF

.....CLAUDIA..HANHI.&.GARY..LAMBETH.....

Surveyed SEPT.30 1999., by J.MILLER.....