


T. 3 S., R. 32 E., W.M.

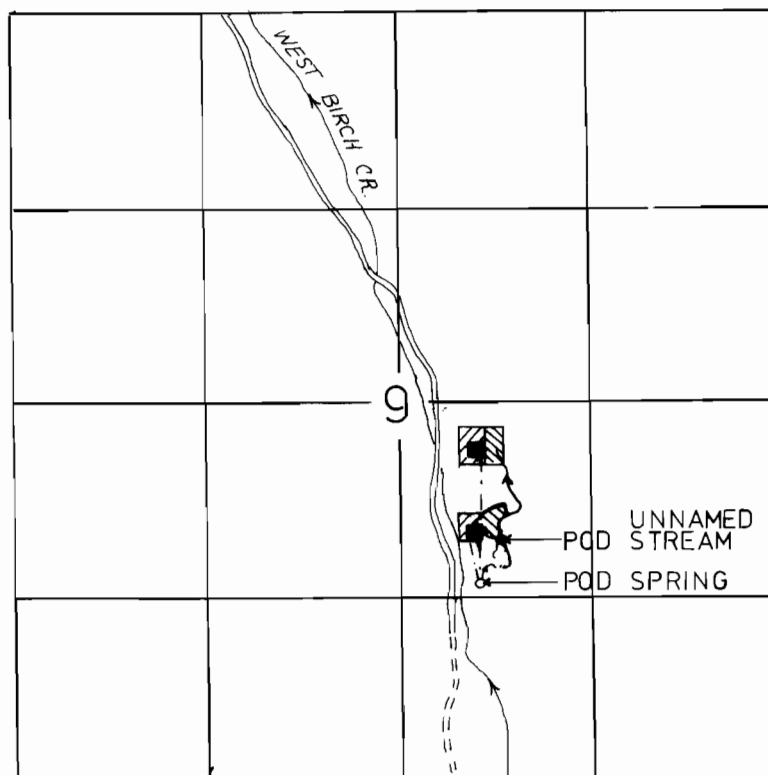

POD STREAM - 950' S. AND 675' E. FROM CEN. COR. SEC. 9.
POD SPRING - 1250' S. AND 550' E. FROM CEN. COR. SEC. 9.

SPRING IRRIGATION  1st Ac.
STREAM IRRIGATION  2nd Ac.

FINAL PROOF SURVEY

UNDER

Application No. 52959 Permit No. 40301
IN NAME OF

RONALD L. AND DELORES COLCORD, ESTATE

Surveyed 7-30, 1993, by J. MILLER