


T. 14 S., R. 32 E., W.M.

RECEIVED

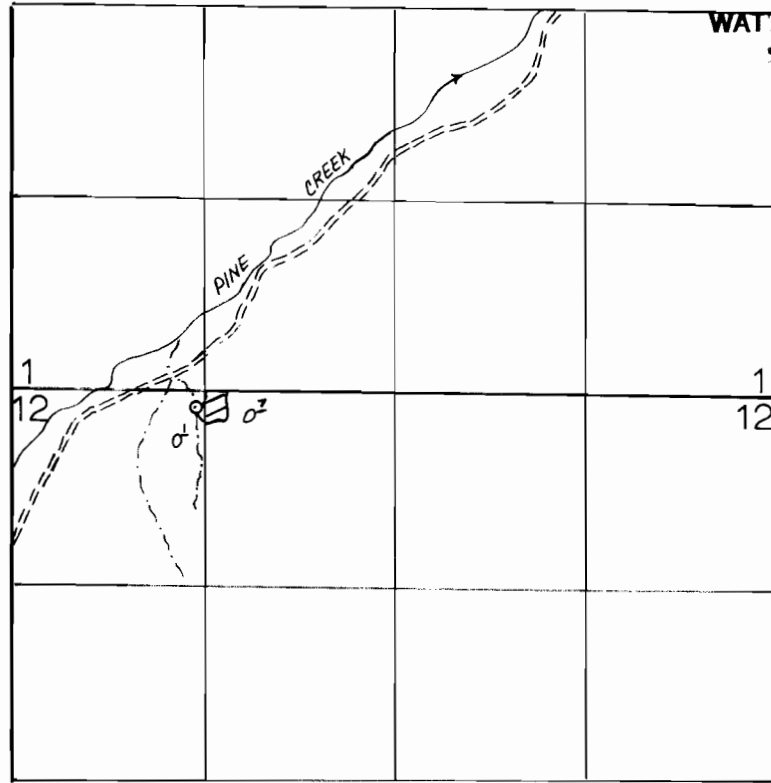

POD -100' SOUTH AND 50' WEST FROM THE NE CORNER OF NW 1/4 NW 1/4, SECTION 12.

FINAL PROOF SURVEY

UNDER

Application No. 65526 Permit No. 47985

IN NAME OF

VERL G. AND DOROTHY BROUGH

Surveyed 6-21, 1988, by V. L. CHURCH

