


# T. 27 S., R. 34 E., W.M.

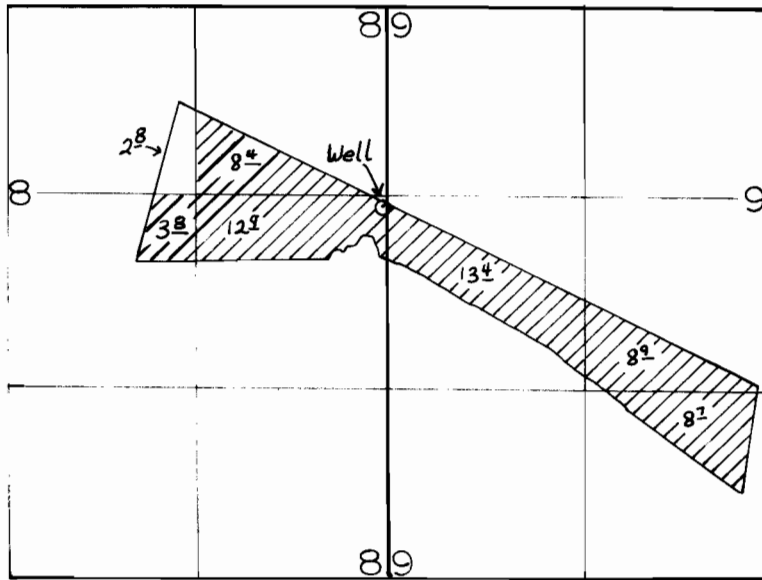

DIV PT - 60 feet South and 50 feet West from the  
E 1/4 Corner of Section 8.

## FINAL PROOF SURVEY

UNDER

Application No. G-10357 Permit No. G-9575  
IN NAME OF

JOHN F. AND KAREN J. STARBUCK

Surveyed 10-31, 1990, by K.KEMP