


T. 2 N., R. 33 E., W.M.

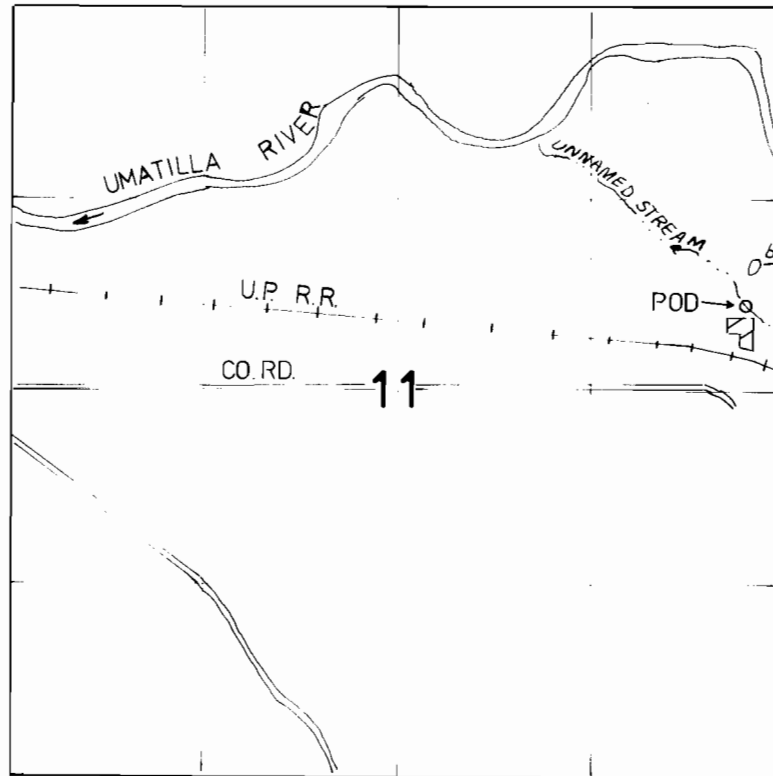

POD - 600' N. & 250' W. FROM THE EAST 1/4 COR. SEC. 11.

1" = 1320'

FINAL PROOF SURVEY

UNDER

Application No. 58642 Permit No. 44221
IN NAME OF

JIM KLEINMAN

Surveyed January 25, 1994, by J. Miller