


T. 22 & 23 S., R. 32 E., W. M.

T. 22 S. R. 31 E.

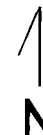

POD 1




POD 2



POD 3

1" = 1320'

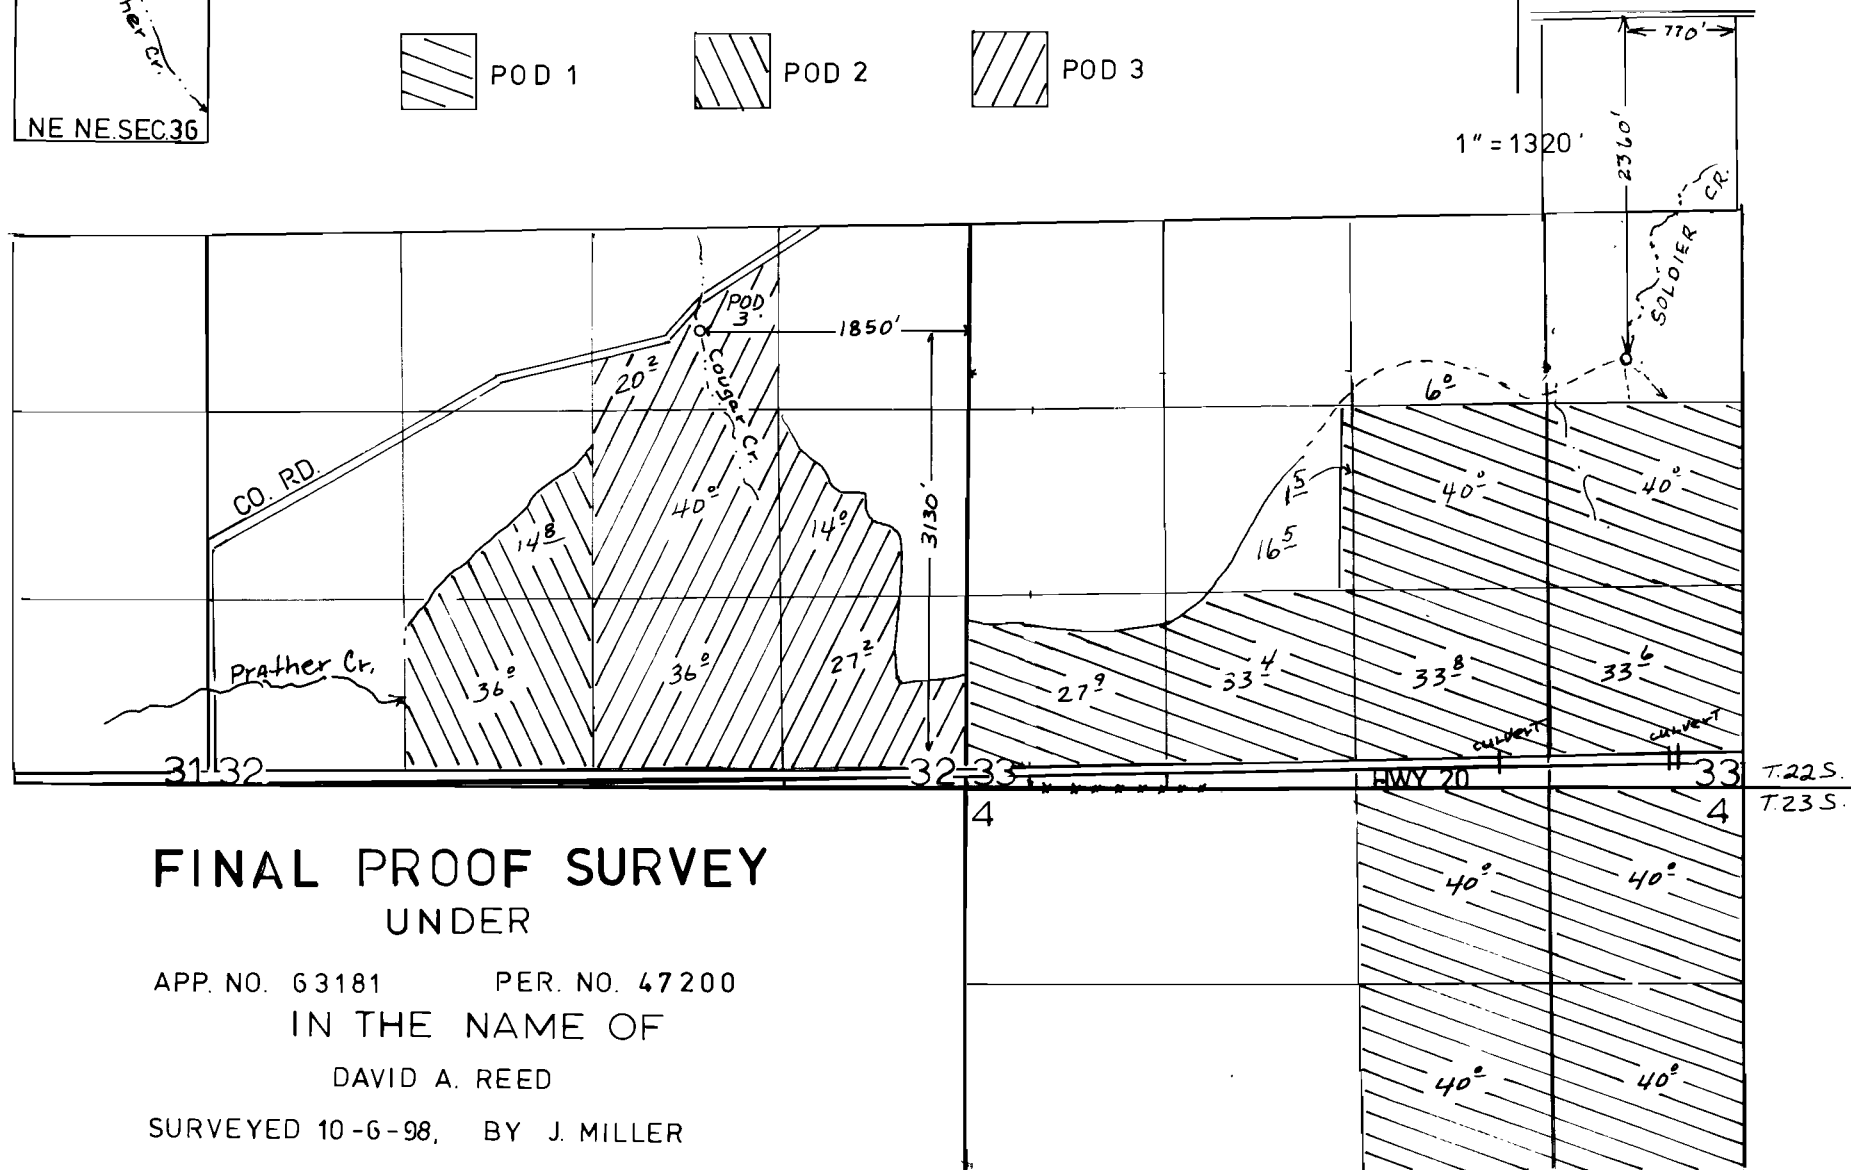

FINAL PROOF SURVEY UNDER

APP. NO. 63181 PER. NO. 47200
IN THE NAME OF
DAVID A. REED
SURVEYED 10-6-98, BY J. MILLER