


# T. 12 & 13 S., R. 32 E., W.M.

RECEIVED

JUL 11 1993  
WATER RESOURCES DEPT  

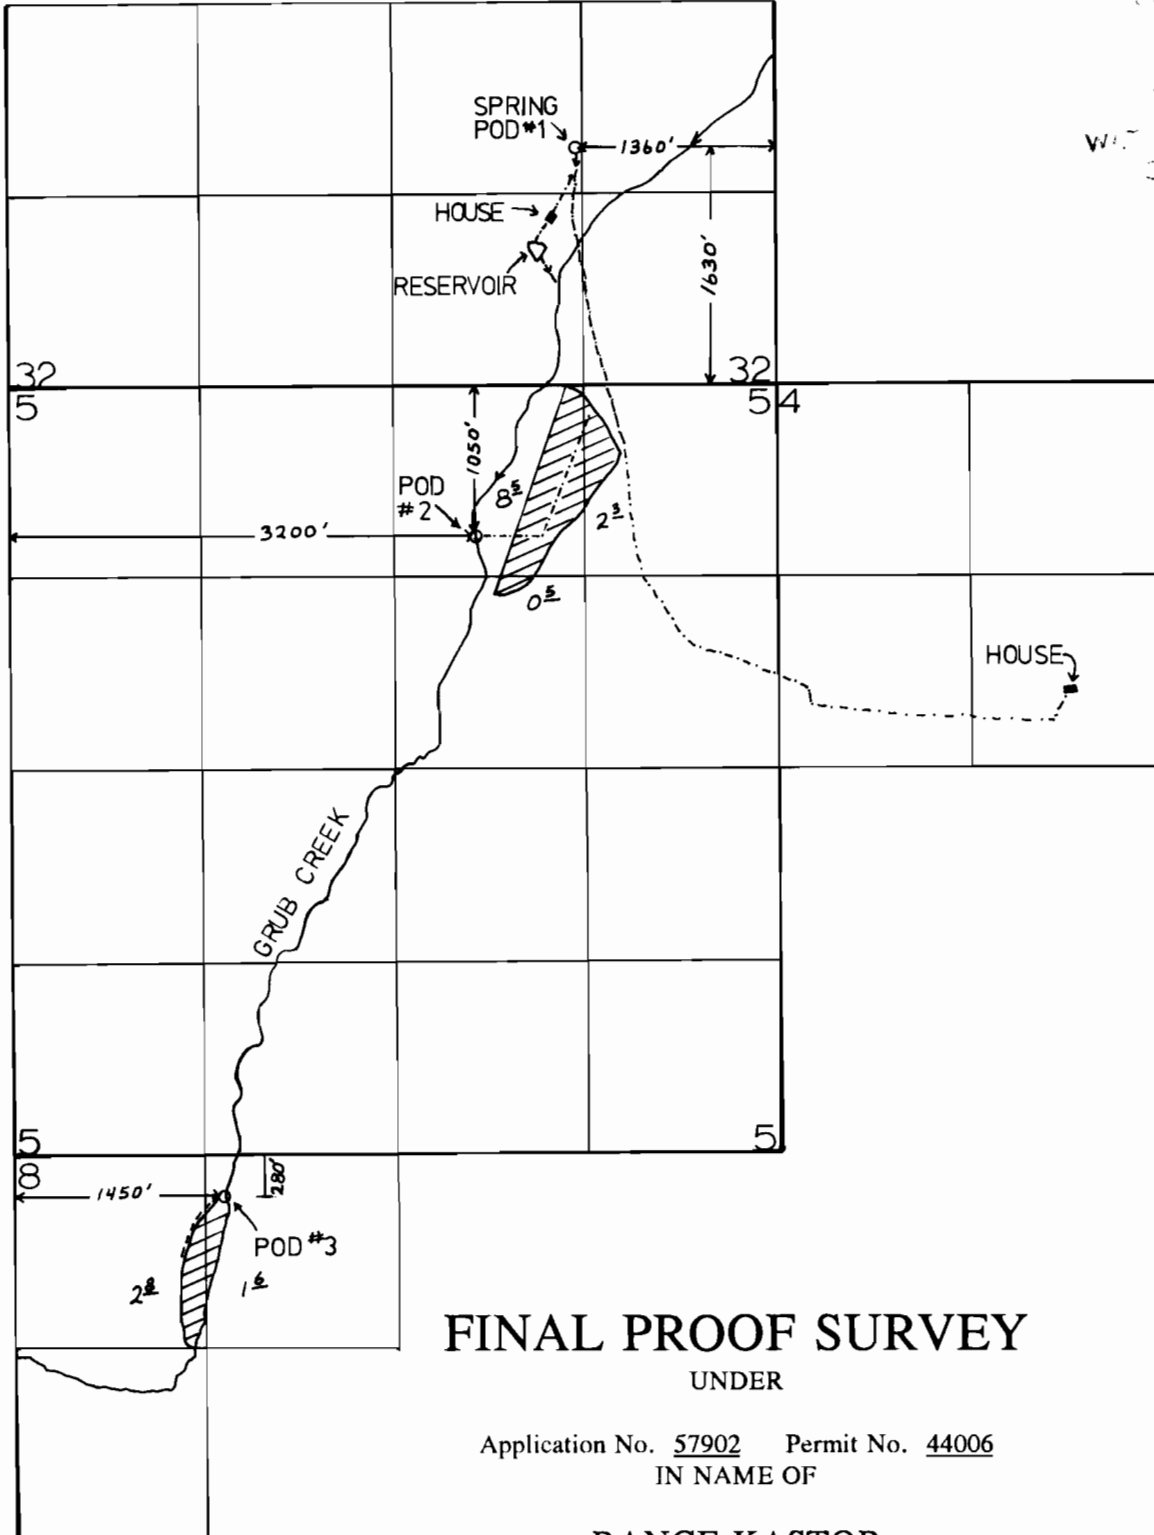

## FINAL PROOF SURVEY

UNDER

Application No. 57902 Permit No. 44006  
IN NAME OF

RANCE KASTOR

Surveyed 11-15, 1991, by J. MILLER