


Township 15 S., Range 30 E., W.M.

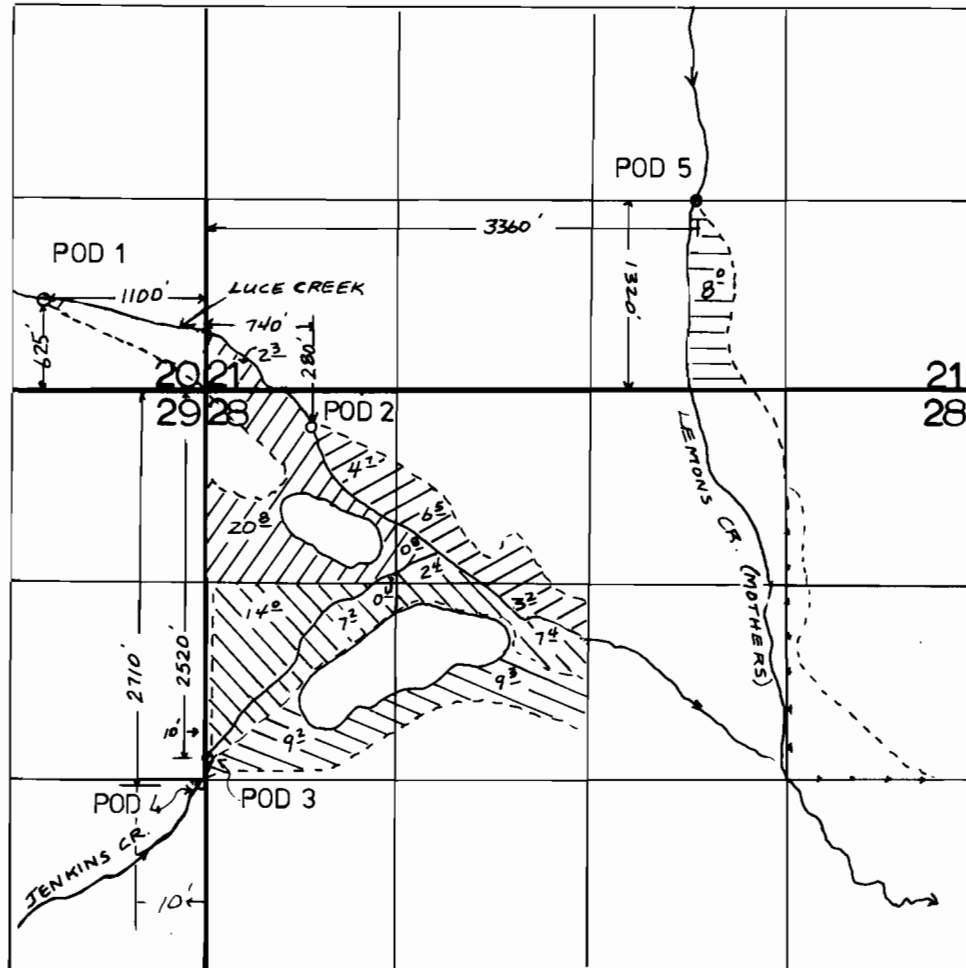

1" = 1320'

-  POD 1
-  POD 2
-  POD 3
-  POD 4
-  POD 5

FINAL PROOF SURVEY UNDER

Application No. 46293 Permit No. 34339
IN NAME OF
INGLE BUTTE RANCH, INC

Surveyed August 10 1995 by J. Miller