


Township 18 South, Range 28 East, W.M.

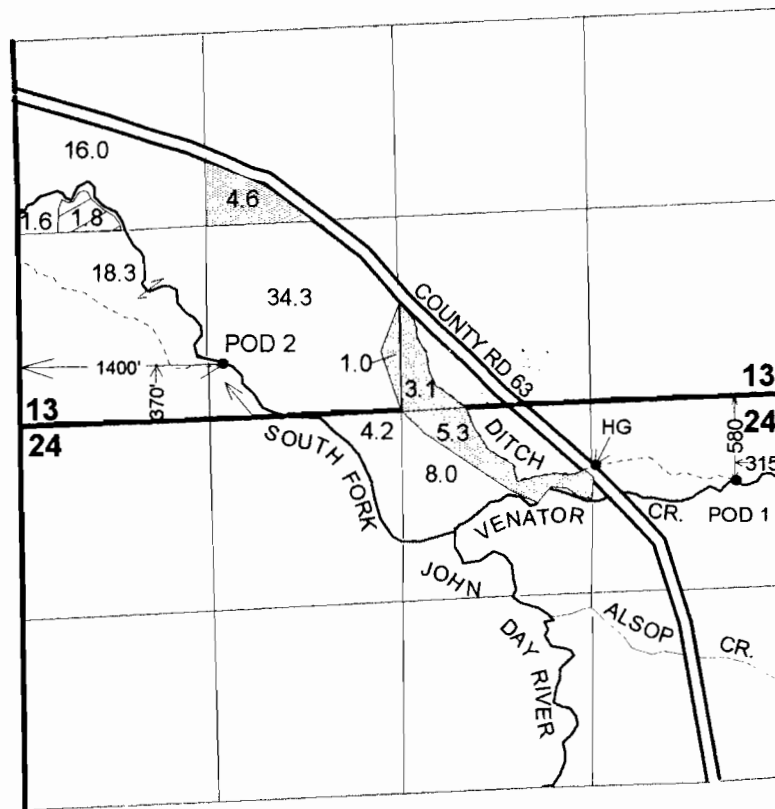

1" = 1320'

**FINAL PROOF SURVEY
UNDER**

Application No. 66015 Permit No. 48044

IN THE NAME OF

Surveyed Aug 03, 2000 by J. Miller

RECEIVED

DEC 02 2002

WATER RESOURCES DEPT.
SALEM, OREGON