


T. 25 S., R 34 E., W. M.

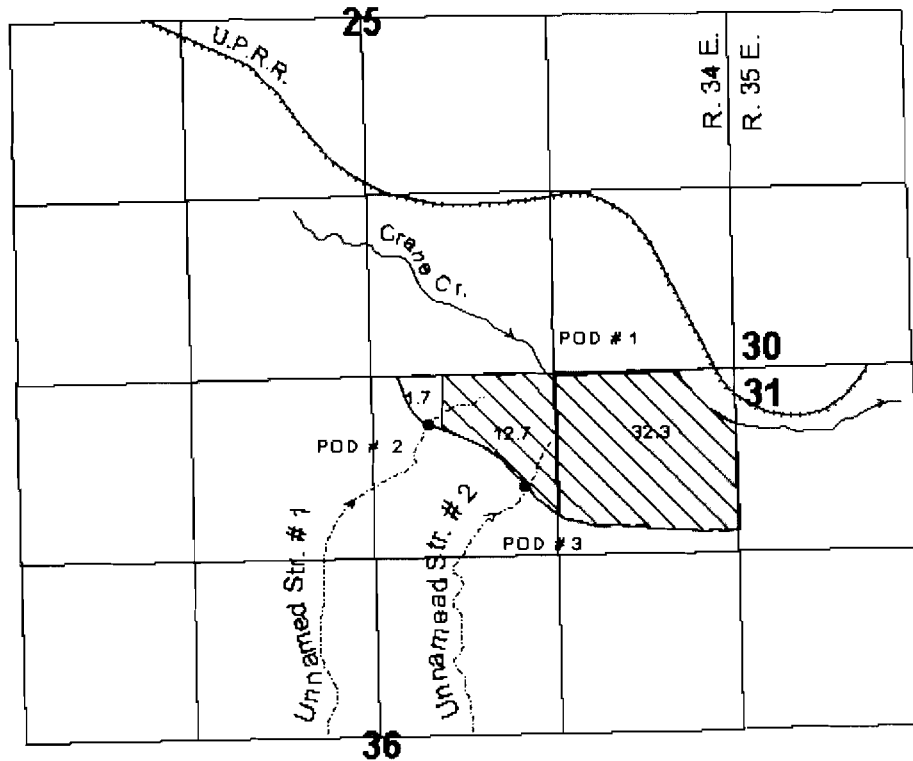

POD #1 - CRANE CREEK - 10' S. and 1375' W. from NE Corner, Section 36.
 POD #2 - UNNAMED STR. #1 - 365' S. and 912' W.
 POD #3 - UNNAMED STR. #2 - 838' S and 227' W.
~~ALL BEING FROM THE NORTHEAST 1/4 CORNER, SECTION 36.~~
 Both from the NE Corner of the NW 1/4 NE 1/4, Section 36.

FINAL PROOF SURVEY UNDER

Application No. 61425 Permit NO. 45758

IN THE NAME OF

Calvin C. Sample

Surveyed 09-18-2001, by J. Miller