


# T. 5 N., R. 36 E., W.M.

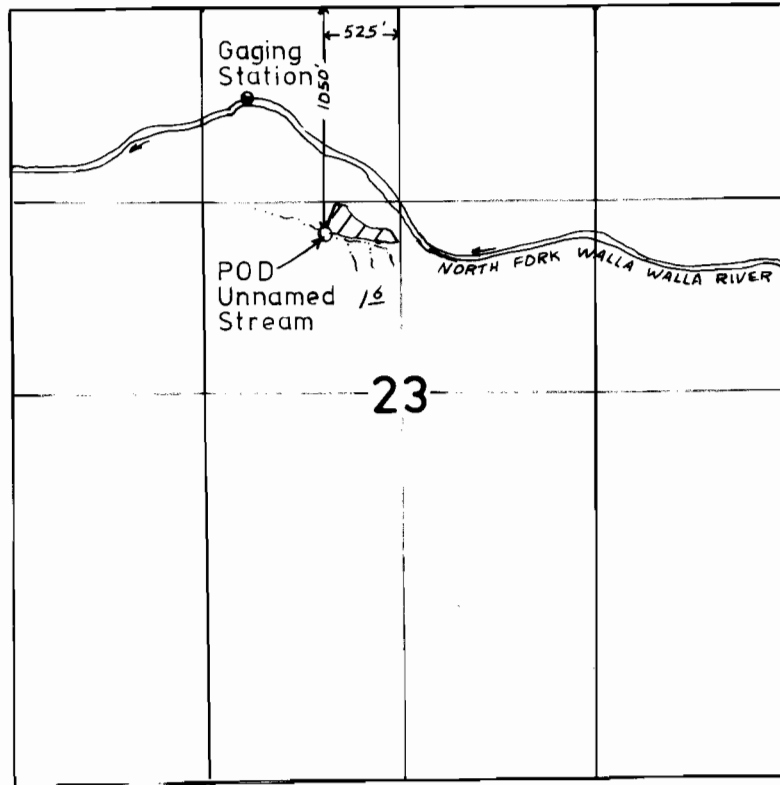

## FINAL PROOF SURVEY

UNDER

Application No. 59950 Permit No. 46176

IN NAME OF

ALBERT T. MORRIS

Surveyed 7-14, 1993, by J. MILLER