


T. 2 N., R. 32 E., W.M.

NE 1/4 SE 1/4 SEC. 35

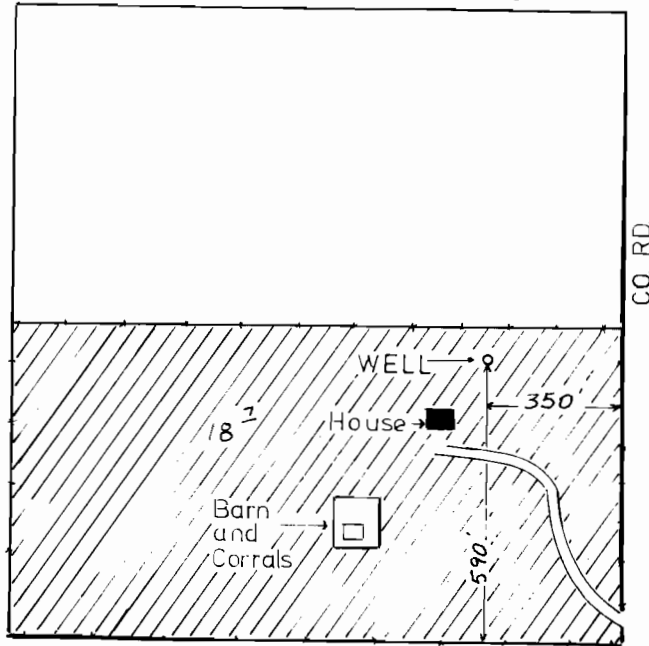

1" = 400'

FINAL PROOF SURVEY

UNDER

Application No. G-10771 Permit No. G-9870
IN NAME OF

WARREN D. STEWART

Surveyed April 25, 1994, by J. Miller